


DATE _____

TOWN OF LEXINGTON — BOARD OF PUBLIC WORKS

WATER DIVISION

Sketch of Service Here

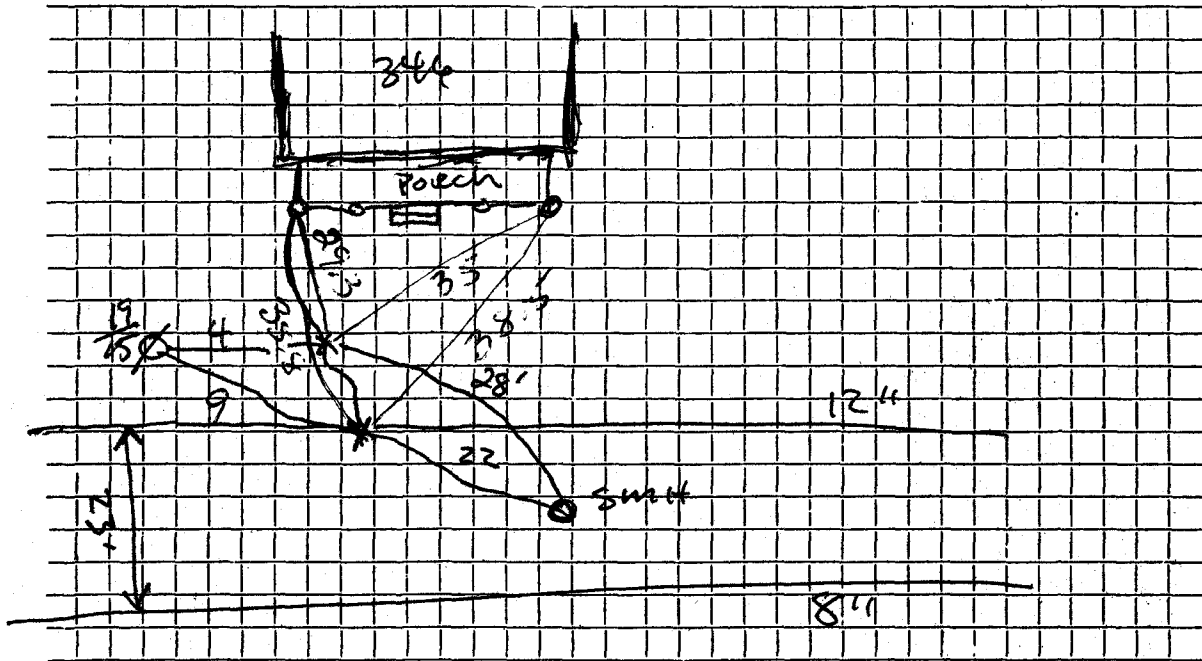

Connection made in Street. Work completed

Remarks: 12" main at edge of road under beam 5' deep

8" 3' outside yellow line 4 1/2' deep