

Name Samuel Clow

Service No. 48. 2794

Address 35 Waltham Street

P Tear down

Location

Kind of Pipe

Size

Size of Main

~~Repair—Renewal—New Service~~

Location

Date 1939	Material	Amount	Total	Date	Amount
Sept. 21	14 hrs. @ 55¢	7 70		September 20, 1939	25 00
<i>Cont</i>	1 " @ 60¢	60		Deposited	
<i>10/30/39</i>	1 " @ 65¢	65	8 95	Refunded	3 32
	10% Overhead		89		21 68
	11' 3/4" Copper tubing @ 15¢		1 65		
	1 3/4" C. x 1/2" I.S. & W.		2 10		
	1 3/4" C. Union		52		
	1 1" Close Nipple		32		
	1/2 hr. compressor @ 3.00		1 50		
	1 trucking @ 75¢		75		
			16 68		
	Sidewalk patching		5 00		
	Labor		21 68		

Hadley Press, Inc., Lexington

DATE Sept 19, 1939

TOWN OF LEXINGTON—BOARD OF PUBLIC WORKS

WATER DIVISION

The undersigned applies for a supply of water at No. 35 Hathorn St. and hereby agrees to comply with the rules and regulations as now, or at any future time, established by the Board of Selectmen.

Am't. of Estimate \$ 25-⁰⁰

Owner Samuel Glaw


Am't. Paid \$ _____

Address 35 Hathorn St.

Builder _____

J.M.V.

Sketch of Service Here

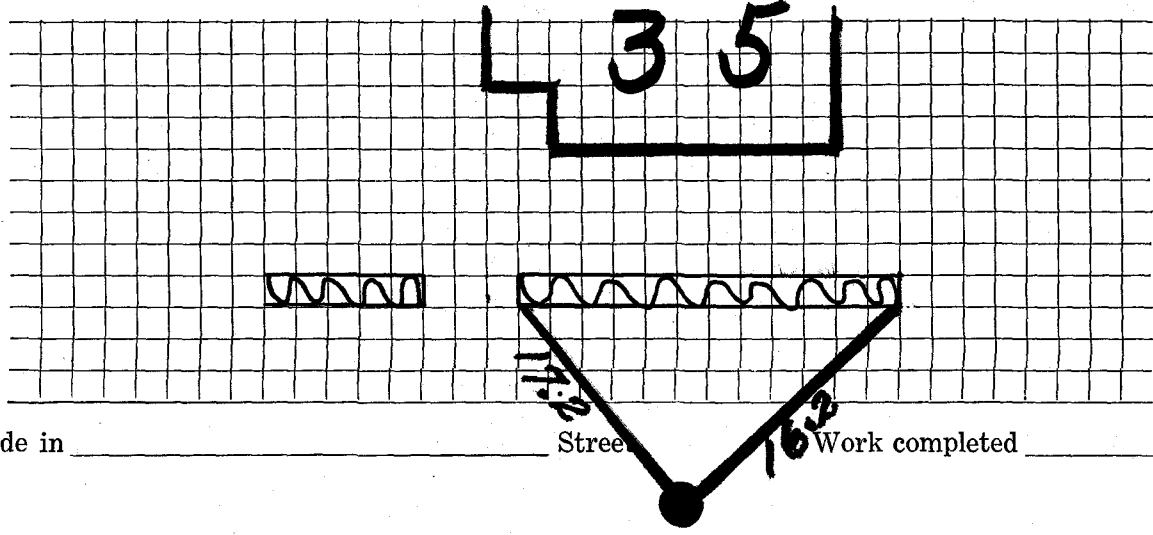

*3/4 C
MAY BE TARDOWN*

Connection made in _____ Street _____ Work completed _____ 19

Remarks: