


DATE 1/23/2017

TOWN OF LEXINGTON — BOARD OF PUBLIC WORKS
WATER DIVISION

Sketch of Service Here

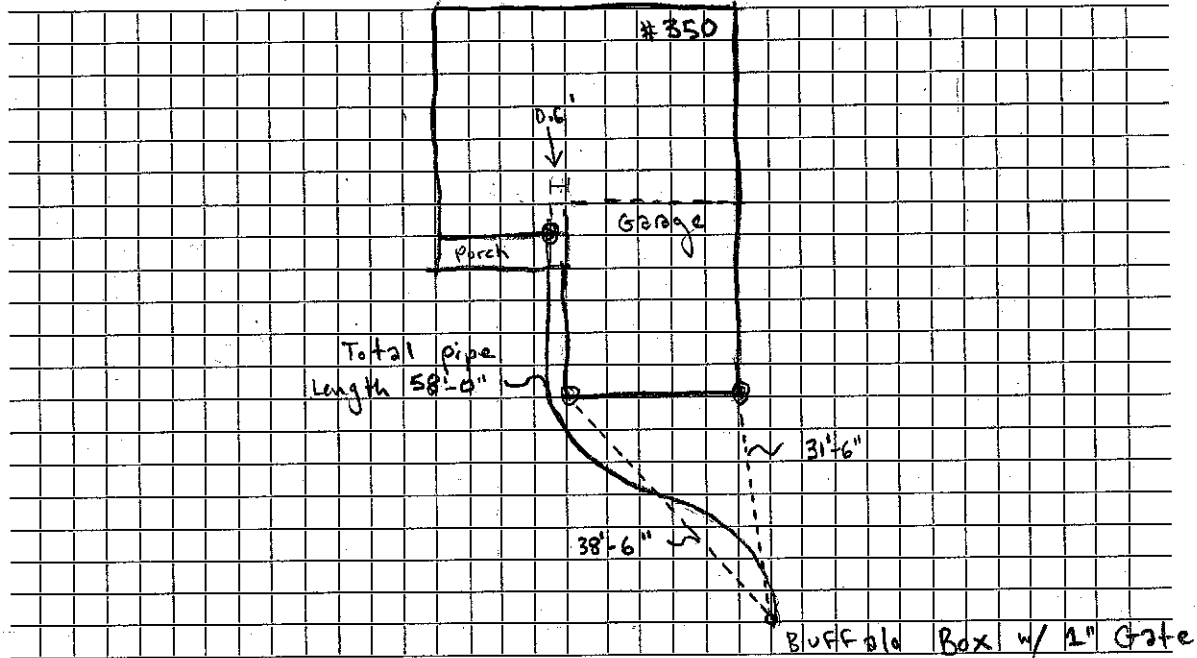

Connection made in 350 Waltham Street. Work completed

Remarks: