

WATER SERVICE RECORD

Name CATHERINE JONES

Service No.

Address 354 WALTHAM ST.

Location

Repair—Renewal—New Service RENEWAL - KIRKLAND: SHAW - #833


Date		Material	Amount	Total	Date	Amount
7/9	96	60' OF 3/4" COPPER				
					7-19-78	
					19' 3/4" Copper	
					1 3/4" Corp Cock	
					1 3/4" Curb Cock	
					1" Style 38	
					1" L.h. Coupling	
					1" X 6" L.h. Nipple	
					1 Box & Rod	

DATE 7/9/96

TOWN OF LEXINGTON — BOARD OF PUBLIC WORKS

WATER DIVISION

Sketch of Service Here

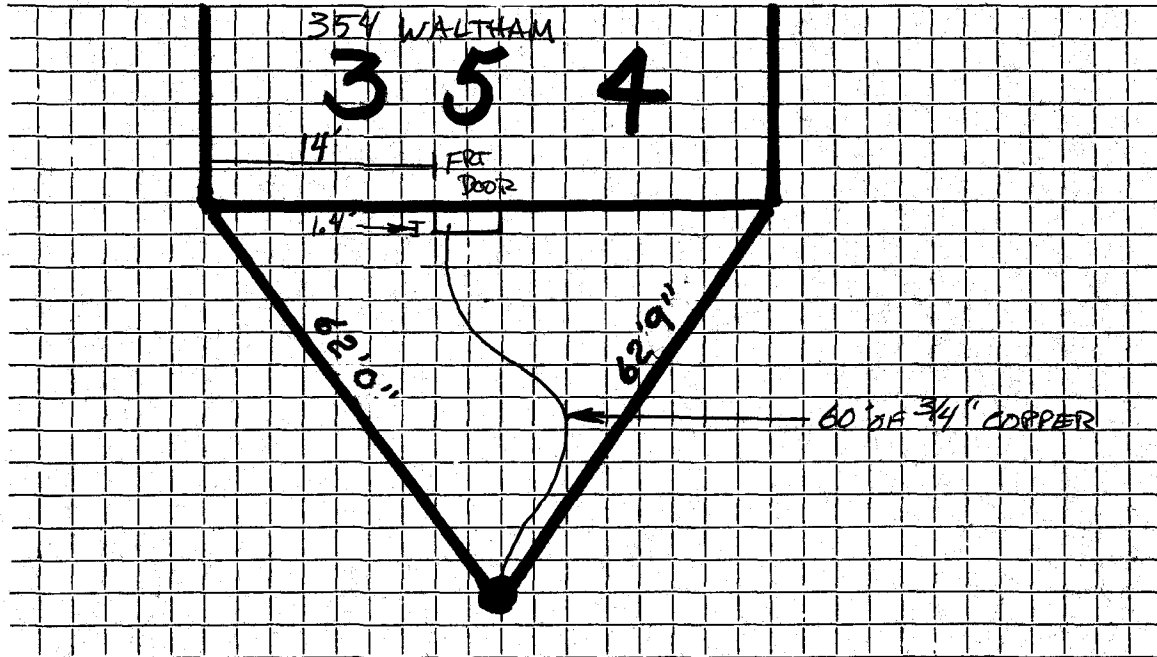

Connection made in Street. Work completed

Remarks:
.....
.....