

WATER SERVICE RECORD

Name

Service No.

Address 355 Waltham ST

Location

LOT-269

Repair—Renewal—New Service


Date	Material	Amount	Total	Date	P.A.O.	Amount
3/29/55	64 3/4 Copper			11/10/69	53'±1'-1" Plastic Pipe	
	1 3/4 - 3 part Union				1 1" Corp	4.5 part
	3/4 x 1/2 S&W				1 1" cork stop	3.5 part
owner dug	Trench				1 1 x 3/4 Reducer	
					buttle box	
	2/7/65 - Freeze up				4' of Insulation @ Prop. line	

DATE

TOWN OF LEXINGTON — BOARD OF PUBLIC WORKS

WATER DIVISION

Sketch of Service Here

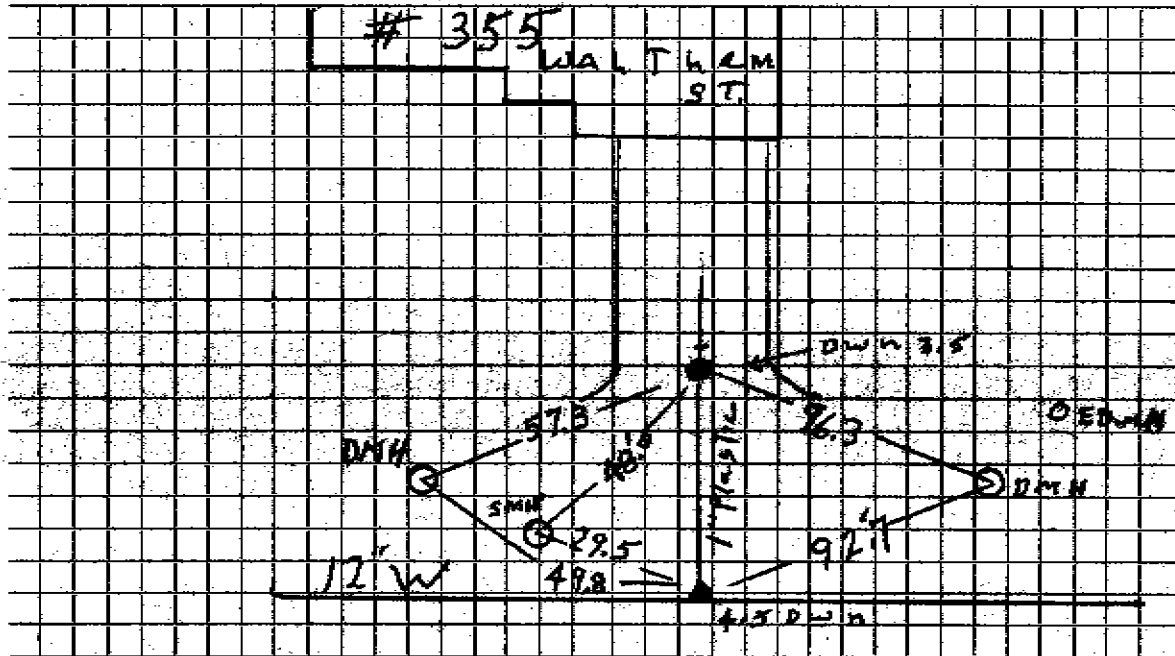

Connection made in..... Street.

Work completed 11/11/09 P.A.O.

Remarks: Curb Down 3.5 w/insulation

Corp. To Curb 1" Plastic Pipe