


DATE _____

TOWN OF LEXINGTON -- BOARD OF PUBLIC WORKS
WATER DIVISION

Sketch of Service Here

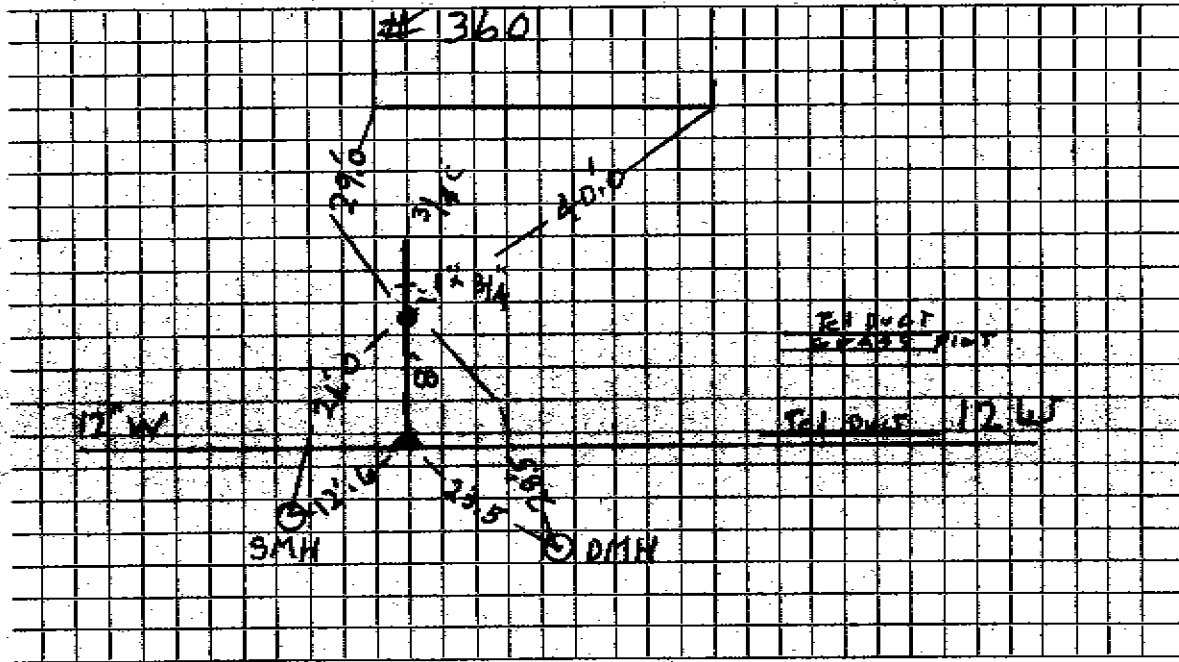

Connection made in..... Street. Work completed 11/6/09 PAO.....
Remarks: Cor p. 4.6 Down, Cook 3.2-Down w/INSL.....