




DATE 5 OCTOBER 1995

TOWN OF LEXINGTON — BOARD OF PUBLIC WORKS

WATER DIVISION

Sketch of Service Here

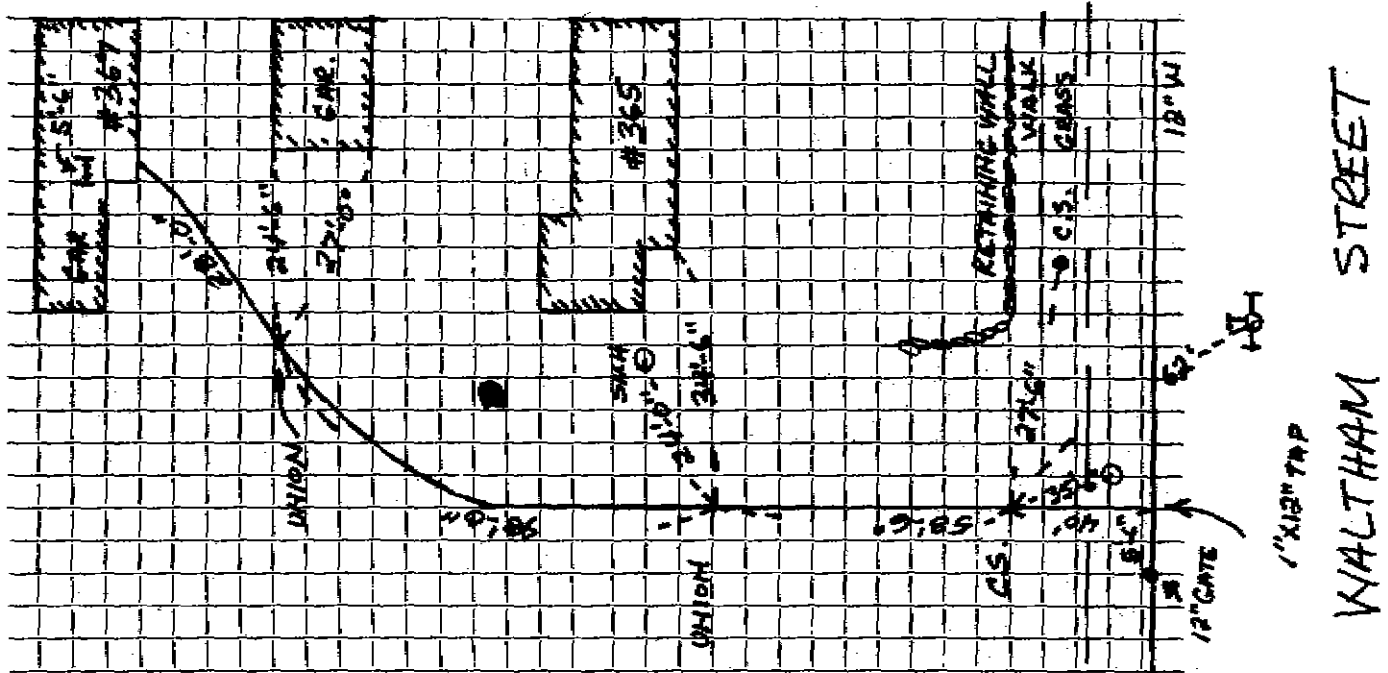

Connection made in WALTHAM STREET Street.

Work completed J.M. McLAUGHLIN, INC.

Remarks: ON 12" Water Main

BOOK 96A

J.W.