

Name Jenney Manufacturing Co.,

Service No. ~~52~~ 283

Address Boston, Mass.
384 Waltham St.

384 Waltham Street

Location Station - Corner Marrett Road & Waltham Sts.

Kind of Pipe

Size

Size of Main

Repair—Renewal—New Service

Location

Date
1939

Material

Amount

Total

Date

Amount

Oct. 11

12 hrs. @ 50¢ 6 00
 74 " @ 55¢ 40 70
 16 " @ 60¢ 9 60
 2 " @ 65¢ 1 30
 16 " @ 70¢ 11 20
 10% Overhead
 68' 1" Copper tubing @ 18¢
 1 1" x 3/4" C.S. & W.
 1 1" C. Union (3 part)
 2 hrs. trucking @ 75¢
 Trench repairs

68 80
 6 88
 12 24
 2 15
 95
 1 50
 12 00
 \$104 52

1939

September 28 Deposited
 November 2, 1939 Refunded

125 00
 20 48
 104 52

Labor

TOWN OF LEXINGTON - BOARD OF PUBLIC WORKS

WATER DIVISION

The undersigned applies for a supply of water at No. 384 Waltham St St. and hereby agrees to comply with the rules and regulations as now, or at any future time, established by the Board of Selectmen.

Am't. of Estimate \$ _____


Owner _____

Am't. Paid \$ _____

Address _____

Builder _____

GRAPEVINE

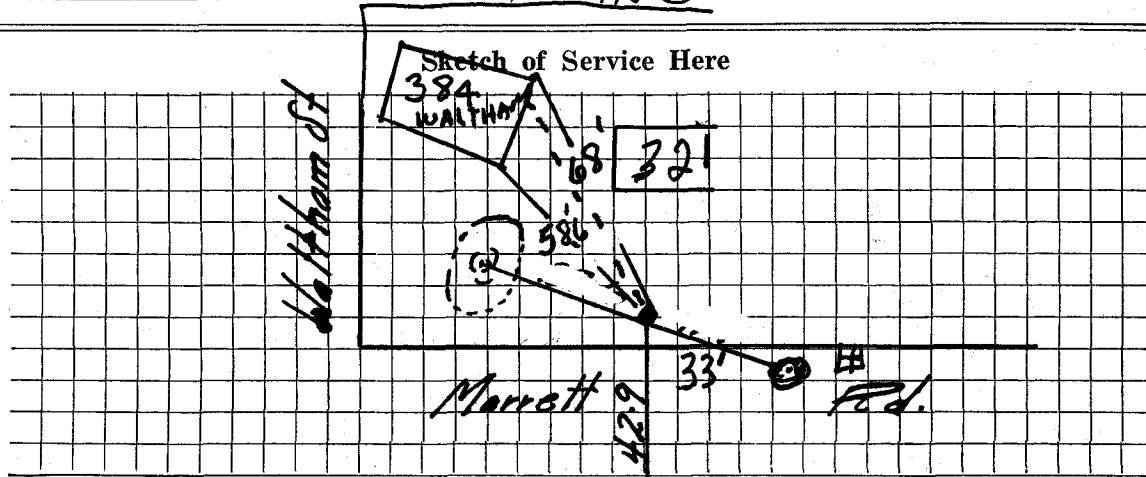

Connection made in _____ Street

Work completed _____ 19

Remarks: