

WATER SERVICE RECORD

Name Homeland Realty Inc.

Service No. 154

Address 405 Waltham Street

Location

~~Repair~~ ~~Renewal~~ New Service


Comm 10-24-60

Date	Material	Amount	Total	Date		Amount
9-15-60	Labor	1.94		<i>7-28-60</i>	<i>Deposit</i>	<i>50.00</i>
	10% O.H.	.19	2.13	<i>8-2-60</i>	<i>Balance</i>	<i>2.35</i>
	36' 3/4" Copper tubing @.42		15.12			<i>26.42</i>
	1 3/4" C x 1/2 I.W.H. Stop & Waste		6.17		NON CHARGE	
	1 hr. Trucking @3.00		<u>3.00</u>	9-15-60	Labor	3.88
			<u>26.42</u>		9' 3/4" Copper tubing @.42	3.78
					1 3/4" C Gurb Cock	6.28
					1 3/4" C Corp Cock	4.91
					1 Box & Rod	4.90
					1 1/2 Striaight Tailpiece	.50
					1 1/2 Offset Tailpiece	.50
						<u>24.75</u>
				<i>4-70/75</i>	<i>1'- 3/4 Comp Cu - 6 Stop</i>	
					<i>1- 3/4 UNION</i>	
					<i>1'- 3/4 COPPER</i>	
					<i>Box - Rod</i>	

TOWN OF LEXINGTON — BOARD OF PUBLIC WORKS

WATER DIVISION

Sketch of Service Here

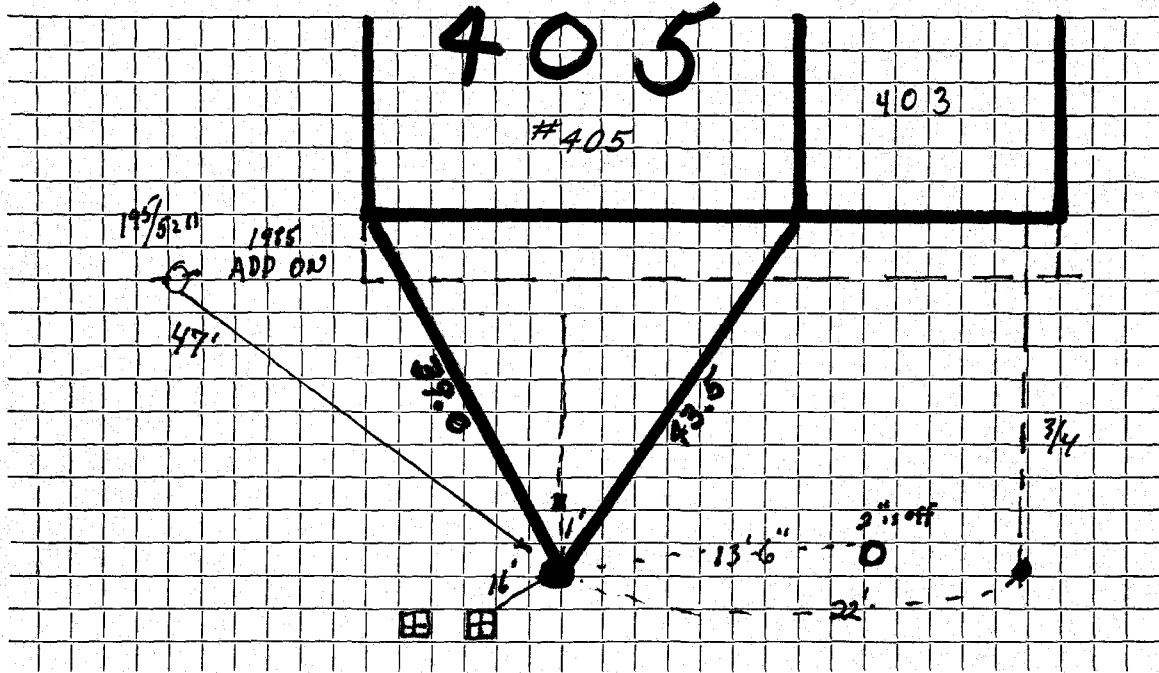

Connection made in Street. Work completed

Remarks: 4-10-95 INST 3/4 COMP CURB 1-3/4 UNION - 1-3/4 COPPER