

WATER SERVICE RECORD

Name

Service No.

Address 410 Waltham Street

Location Lexington, Mass.

~~Repair~~ - Renewal - ~~New Service~~


Com 12-26-50

Date	Material	Amount	Total	Date	Amount
Nov. 3	50				
	37' 3/4 Copper	32.11.84			
	1 - 3/4 x 1/2 I.W.H. Saw	3.76			
					No Charge
				6-13-50	Labor 39 37
				36' - 3/4" Copper Tubing @.23	8 28
				1 - 3/4" Copper Adapter	1 75
				1 - 3/4" C x 3/4" C Curb-cock	3 85
				1 - 3/4" C x 3/4" C Union (3pts)	1 39
				Brox Shovel 3 hrs. @ 9.00	27 00
				Trucking 1 hr. @.75	75
					82 39

DATE \_\_\_\_\_

**TOWN OF LEXINGTON — BOARD OF PUBLIC WORKS**  
**WATER DIVISION**

Sketch of Service Here

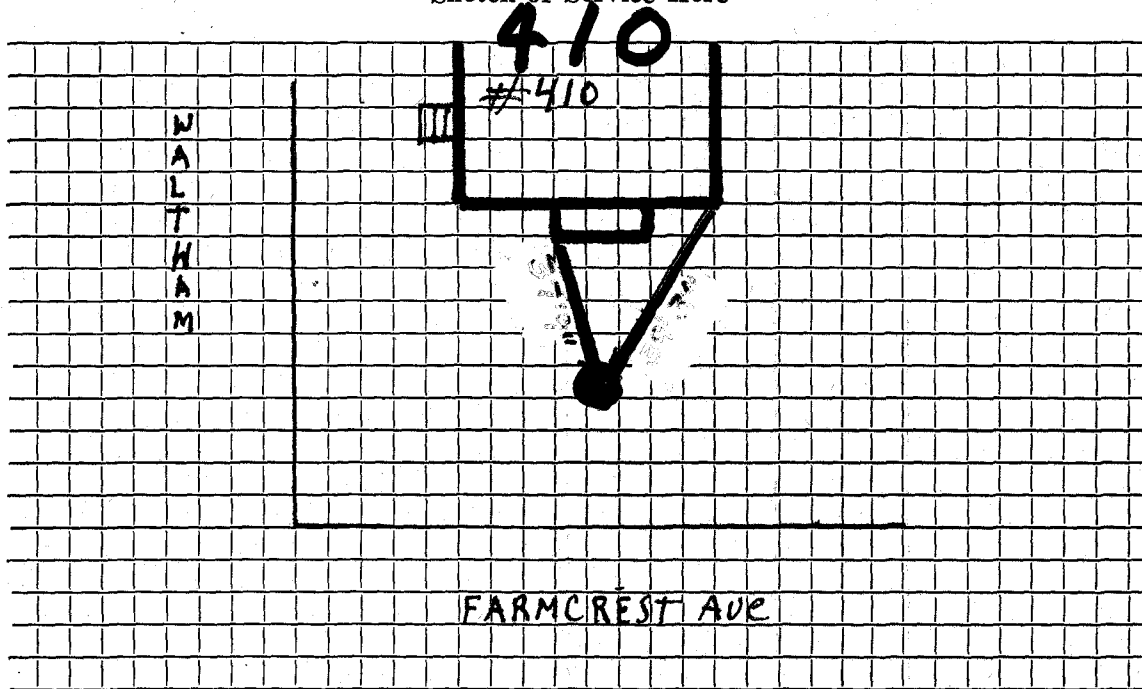

Connection made in ..... Street.      Work completed .....

Remarks: .....  
.....  
.....