

Name Harriet Fletcher

Service No. 80

Address 435 Waltham Street

109

Lexington, Mass.

Location 435 Waltham Street

Kind of Pipe

Size

Size of Main

~~NEW SERVICE~~ New Service

Com. 6-14-49

Location

Date	Material	Amount	Total	Date	Amount
May 25, '49	Labor	24 43	24 43	May 18 '49	50 00
	10% Overhead		2 44	June 24 '49	8 79
	43' - 3/4" Copper Tubing @.24		10 32		41 23
	1 - 3/4" C x 1/8" I.W.H. S&W		3 29	May 25, '49	10 00
	Trucking 1 hr. @.75		75	4' - 3/4" Copper Tubing @.24	96
			41 23	1 - 3/4" C Corp-cock	3 15
3/30/99	McLaughlin			1 - 3/4" C x 3/4" Curb-cock	3 85
87'	1" Copper			1 - Box & Rod	3 95
1	3/4 X 1" Union			1 - 1/2" Offset Tail Piece	37
				1 - 1/2" Straight Tail Piece	37
				Trucking 1 hr. @.75	75
					23 40
	Labor				

TOWN OF LEXINGTON - BOARD OF PUBLIC WORKS

WATER DIVISION

The undersigned applies for a supply of water at No..... St. and hereby agrees to comply with the rules and regulations as now, or at any future time, established by the Board of Selectmen.

Am't of Estimate \$.....


Owner

Am't Paid \$.....

Address

Builder

Sketch of Service Here

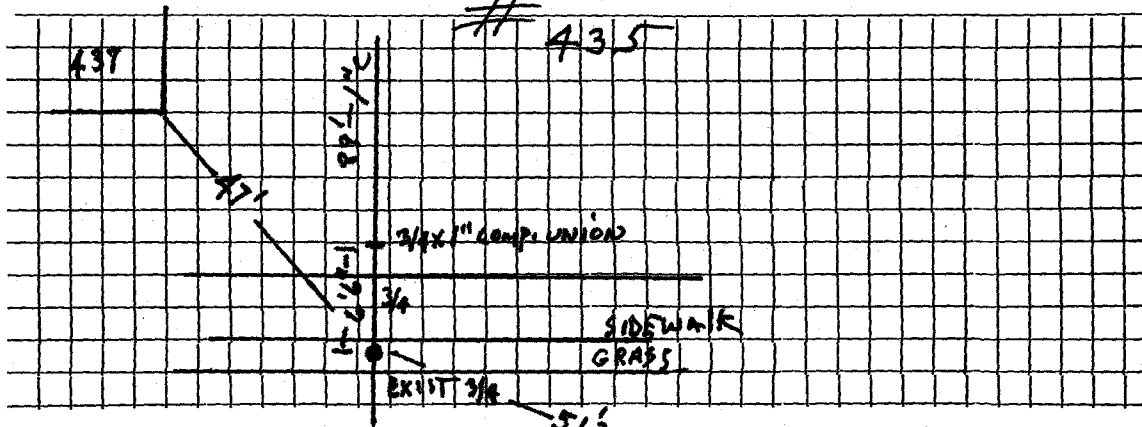

Connection made in Street. 51.3 HYD Work completed19

Remarks: