

Name Garfield Burgess

Service No. 18

Address 437 Waltham Street

Lexington, Mass.

Location 437 Waltham Street

Kind of Pipe

Size

Size of Main

~~XXXXXXXXXXXX~~ New Service Com. June 7, 1948

Location

Date	Material	Amount	Total	Date	Amount
Apr. 3, '48	Labor	2 10	2 10	April 48	25 00
	10% Overhead		21	June 10 '48	6 50
	43' - 3/4" Copper Tubing @ .255	10 97	10 97		18 50
	1 - 3/4" C x 1/2" I.W.H. S & W		3 15	Apr. 3, '48	5 80
	1 - 3/4" C x 3/4" C union 3pts.		1 32	6' - 3/4" Copper Tubing @ .255	1 53
	Trucking 1 hr. @ .75		75	1 - 3/4" C Corp-cock	3 00
			18 50	1 - 3/4" C x 3/4" C Curb-cock	3 68
				1 - Box & Rod	3 50
				Littlefield Shovel 1 hr. @ 7.00	7 00
				1 - 1/2" Offset Tail Piece	30
	Trench dug by owner			1 - 1/2" Straight Tail Piece	30
				Trucking 1 hr. @ .75	75
	Labor				25 86

DATE \_\_\_\_\_

TOWN OF LEXINGTON - BOARD OF PUBLIC WORKS

**WATER DIVISION**

The undersigned applies for a supply of water at No..... St. and hereby agrees to comply with the rules and regulations as now, or at any future time, established by the Board of Selectmen.

Am't of Estimate \$.....

Owner .....


Am't Paid \$.....

Address .....

Builder .....

.....

Sketch of Service Here

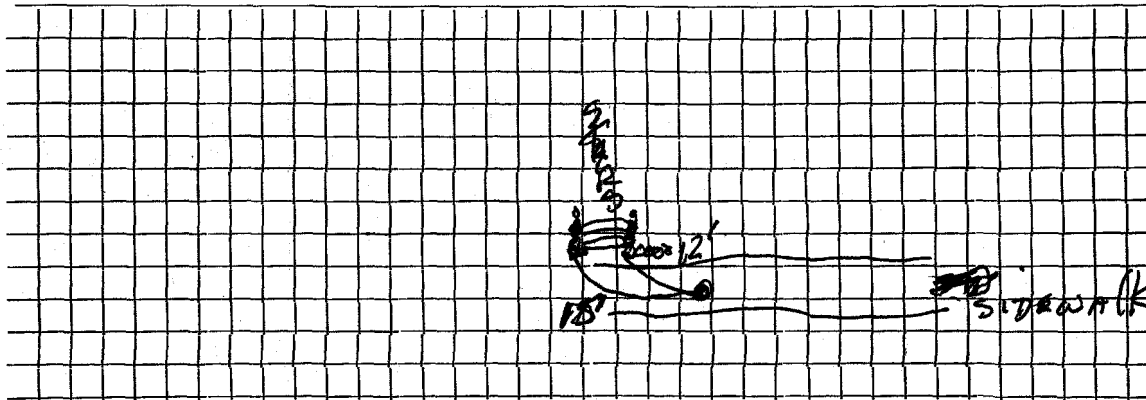

Connection made in ..... Street.

Work completed .....19

Remarks: