

#1710

WATER SERVICE RECORD

Name Charles Ryberg

Service No. 318

Address 438 Waltham Street

Location Lexington

Repair ~~Work~~ - New Service

COM. 2-4-52


Date	Material	Amount	Total	Date	Amount
1/16/52	Labor	1 49	1 49	12-7-51 Deposited	25 00
	10% overhead		15	2-4-52 Void	30
	55' - 3/4" copper tubing @ .3439	18 91		NON CHARGE	25 30
	1 - 3/4" Cx 1/2" I.W.H. stop & waste	4 00		1/16/52 Labor	1 49
	1 hr. trucking		75	33' - 3/4" copper tubing @ .3439	11 34
			25 30	1 - 3/4" C. corp-cock	4 33
				1 - 3/4" C x 3/4" C. curb-cock	4 67
				1 box and rod	4 52
				1 - 1/2" straight tail piece	50
				1 - 1/2" offset tail piece	50
				1 hr. trucking	75
					28 10

DATE _____

TOWN OF LEXINGTON — BOARD OF PUBLIC WORKS

WATER DIVISION

Sketch of Service Here

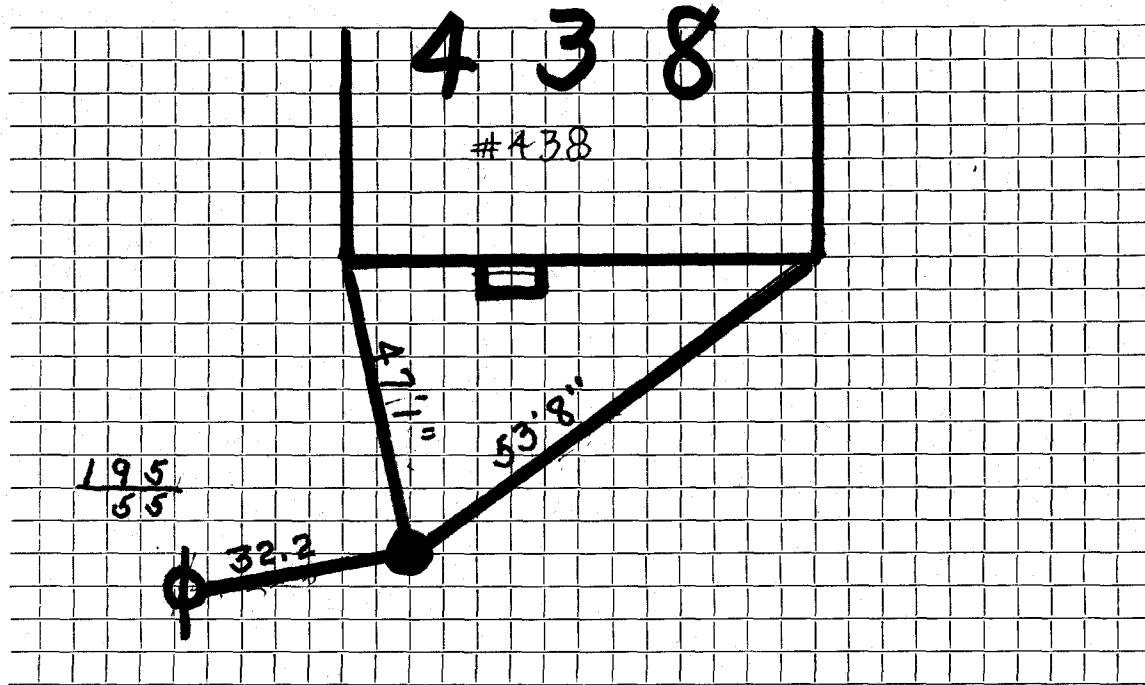

Connection made in Street. Work completed

Remarks:
.....
.....