

WATER SERVICE RECORD

Name

Service No.

Address 440 Waltham Street

Location Lexington, Mass.


~~Repair~~—Renewal—~~New~~Service

Date	Material	Amount	Total	Date	Amount	
	Non-Charge				No Charge	
9-25-50	Labor	6 90	6 90	9-25-50	Labor	22 84
	10% Overhead		69	30' - 3/4" Copper Tubing @.31		9 30
	33' - 3/4" Copper Tubing @.31	10 23	1 - 3/4" Corp-cock			3 60
	1 - 3/4" C x 1/2" I.W.H. S&W	3 76	1 - 3/4" C x 3/4" C Curb-cock			4 40
	Littlefield Shovel 2 hrs. @7.00	14 00	1 - Box & Rod			3 35
	Trucking 1 hr. @.75		75	1 - 1/2" Offset Tail Piece		42
			36 33	1 - 1/8" Straight Tail Piece		42
				Littlefield Shovel 2 hrs. @ 7.00		14 00
				Trucking 1 hr. @.75		75
				Patching 9 x 3		9 00
						68 08

DATE _____

TOWN OF LEXINGTON — BOARD OF PUBLIC WORKS
WATER DIVISION

Sketch of Service Here

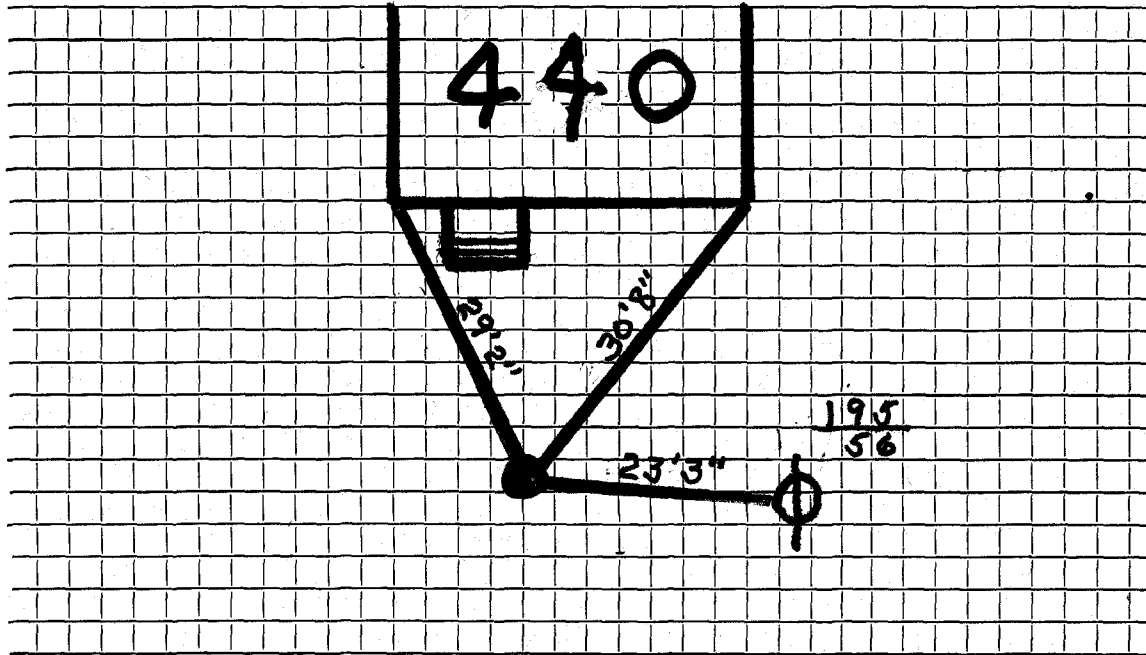

Connection made in Street.

Work completed

Remarks: *Original Service 2-19-30*