


DATE 4/3/17

TOWN OF LEXINGTON — BOARD OF PUBLIC WORKS

WATER DIVISION

Sketch of Service Here

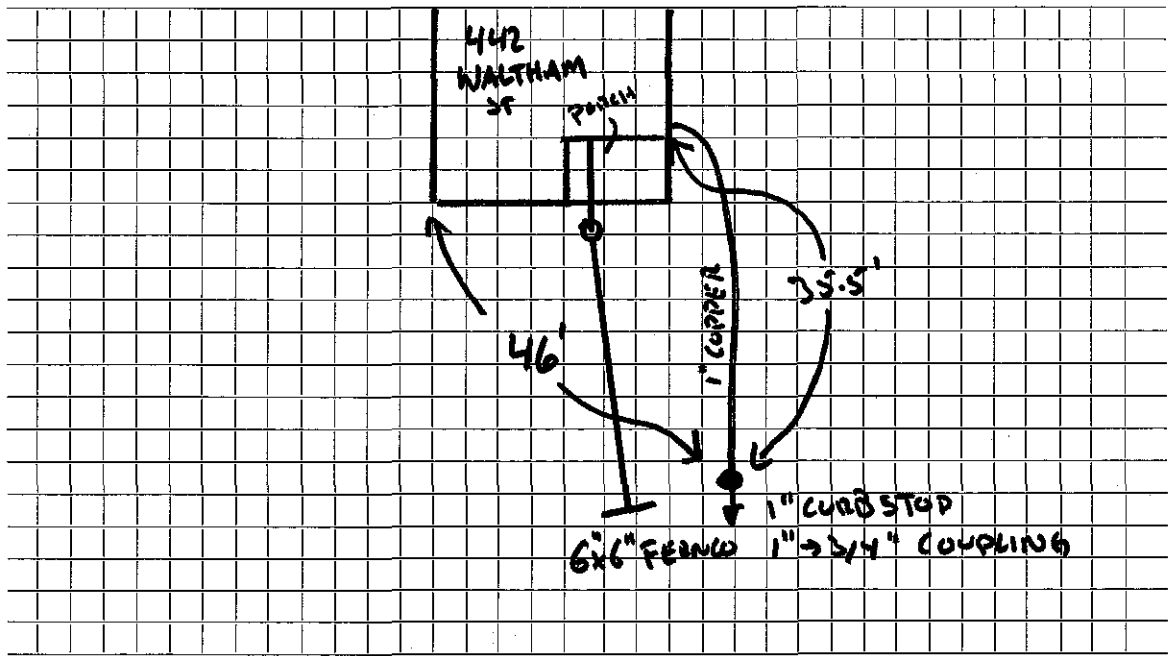

Connection made in WALTHAM Street. Work completed McLAUGHLIN

Remarks:

.....

.....