

Name O. Robert Arnold

Service No.

2840

Address ~~88 Bridge Street, Lexington~~

#4337

443 Waltham St. Location 443 Waltham Street

Kind of Pipe

Size

Size of Main

~~Repair - Renewal~~ - New Service

Location

Date	Material	Amount	Total	Date	Amount
June 24 <i>from 7/20/37</i>	2 hrs. @ .60		1 20	<i>June 21, 1937 Deposited</i>	18 00
	Overhead		12		
	36' 1" Copper Tubing @ .30	10 80			
	1 1" Stop and Waste	3 75			
	2 hrs. Trucking @ .75	1 50			
			17 37		
	Flat Rate 36' @ .50		18 00		
	Labor				

Hadley Press, Inc., Lexington

36'  
50'  
180'

DATE June 21 1937

# TOWN OF LEXINGTON—BOARD OF PUBLIC WORKS

## WATER DIVISION

The undersigned applies for a supply of water at No. 443 Kaltham St. and hereby agrees to comply with the rules and regulations as now, or at any future time, established by the Board of Selectmen.

Am't. of Estimate \$ 18<sup>00</sup>

Mr. O. Robert Arnold


Am't. Paid \$ \_\_\_\_\_

Address

88 Bridge St  
Lexington

Builder \_\_\_\_\_

Sketch of Service Here

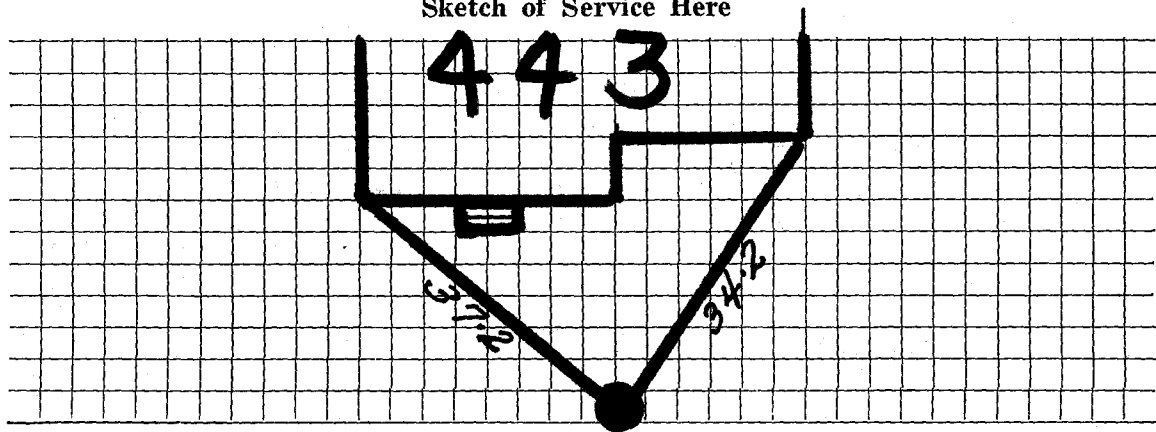

Connection made in \_\_\_\_\_ Street.

Work completed \_\_\_\_\_ 19

Remarks: