

WATER SERVICE RECORD

Name

Harry Van Norden

Service No.

Address

447 WALTHAM ST.

Location

Repair

~~Renewal~~

New Service

Valeri #0529


Date	Material	Amount	Total	Date	Amount
4/20/90	40 LF 3/4" COPPER				
				6-26-90	
				10 1/2 3/4" Copper	
				1 3/4" C. Corp Cock	
				1 3/4" C. Curb Cock	
				1 6" X 3/4" Saddle	
				1 1" L.L. Coupling	
				1 Box + Rod	

DATE _____

TOWN OF LEXINGTON — BOARD OF PUBLIC WORKS

WATER DIVISION

Sketch of Service Here

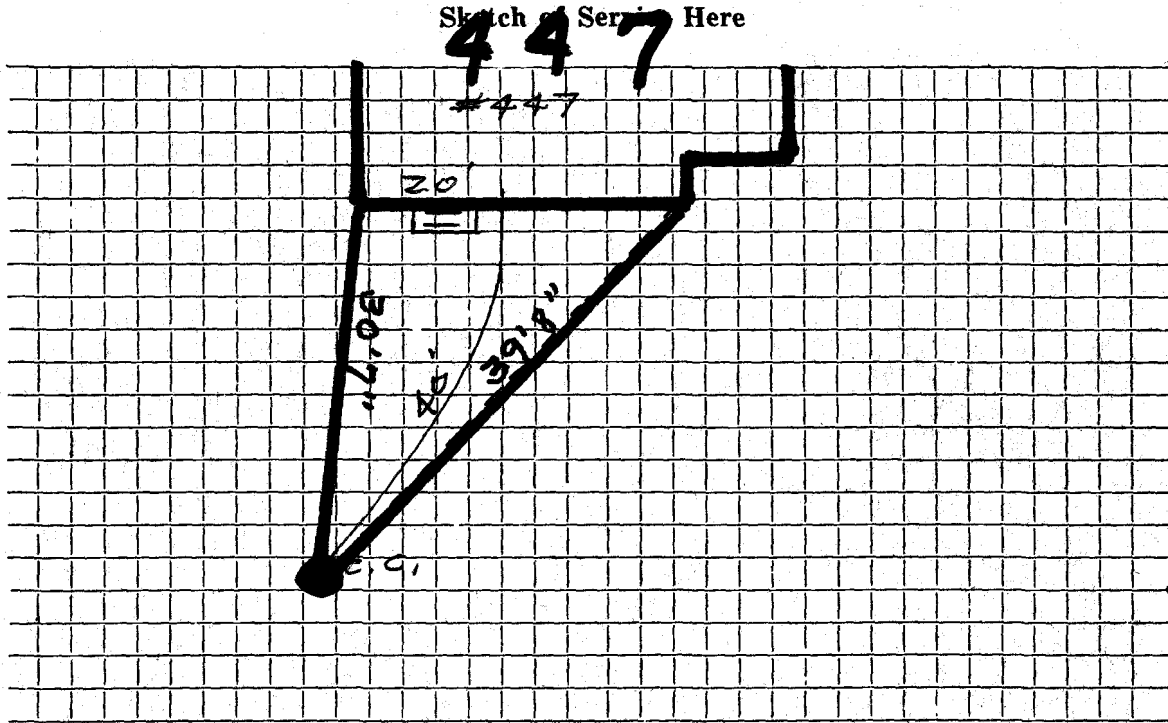

Connection made in WALTHAM Street. Work completed

Remarks: TIES TO CURB STOP. DID NOT CHANGE