


Water Service Tie Card  
TOWN OF LEXINGTON

455 Waltham St

MASSACHUSETTS

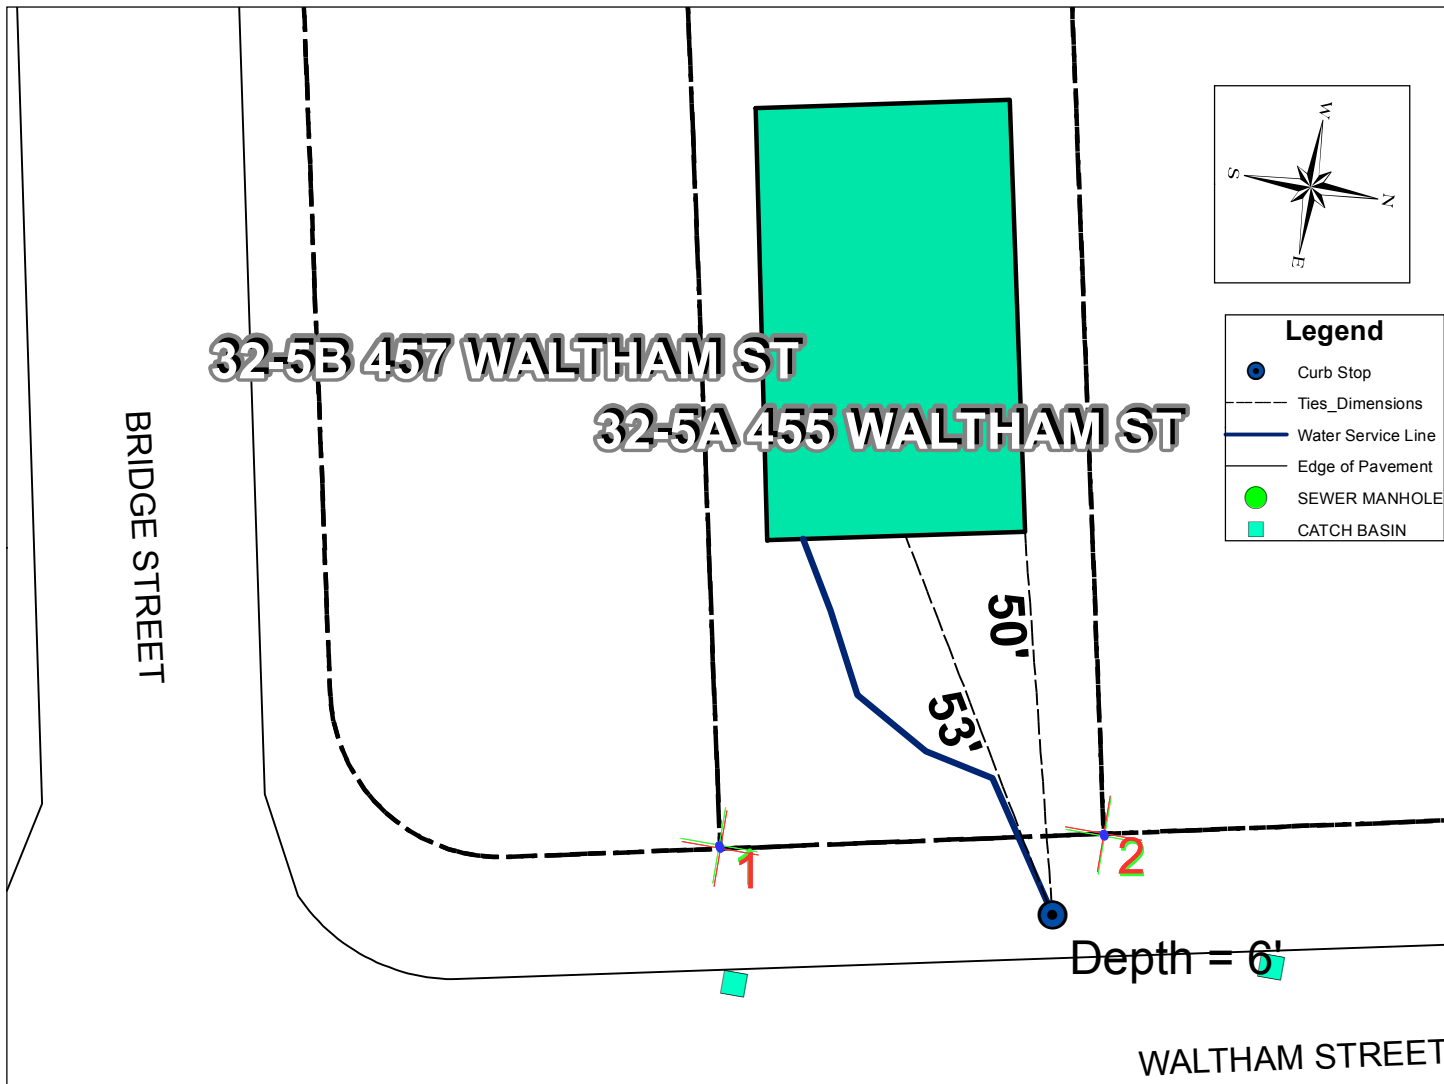

Address	Map and Lot	Permit Number	Contractor Name	Inspector
455 Waltham St	32-5A	6195	Iovino Excavating	msprague
Date	Material	Depth of Cover	Amount	
5/29/2015	3/4" Copper	6 ft	6"	
	1" Inceaser	6 ft	1	
	1" Copper type "k"	6 ft	1 ft	
	1" Curb Valve and Buffalo Box	6 ft	1 ft	
	1" Copper type "k"	6 ft	62 ft to HSE	
Type of work completed				

New 1" water service to house from curb stop. New house on lot old house removed.