

ENGINEERING CONTRACT

WATER SERVICE RECORD

Name Chisholm Construction Co.

Service No. 10

Address 457 Waltham Street

Location

~~Repair~~ New Service Lexington Sewerage Co. Permit #222

OCT 25 1965


Date		Material	Amount	Total	Date	Amount
4-1-65		Labor	4 73		3-18-65	50 00
		10% O.H.	47	5 20	11-28-65	26 37
	8'	3/4" Copper Tubing @.142		3 36		29 63
	1	3/4" Corp Cock		7 41		
	1	3/4" Curb Cock		8 76		
	1	Box & Rod		4 90		
				29 63		
4-9-65	42'	3/4" Copper tubing				

Deposit
Refund

TOWN OF LEXINGTON — BOARD OF PUBLIC WORKS

WATER DIVISION

Sketch of Service Here

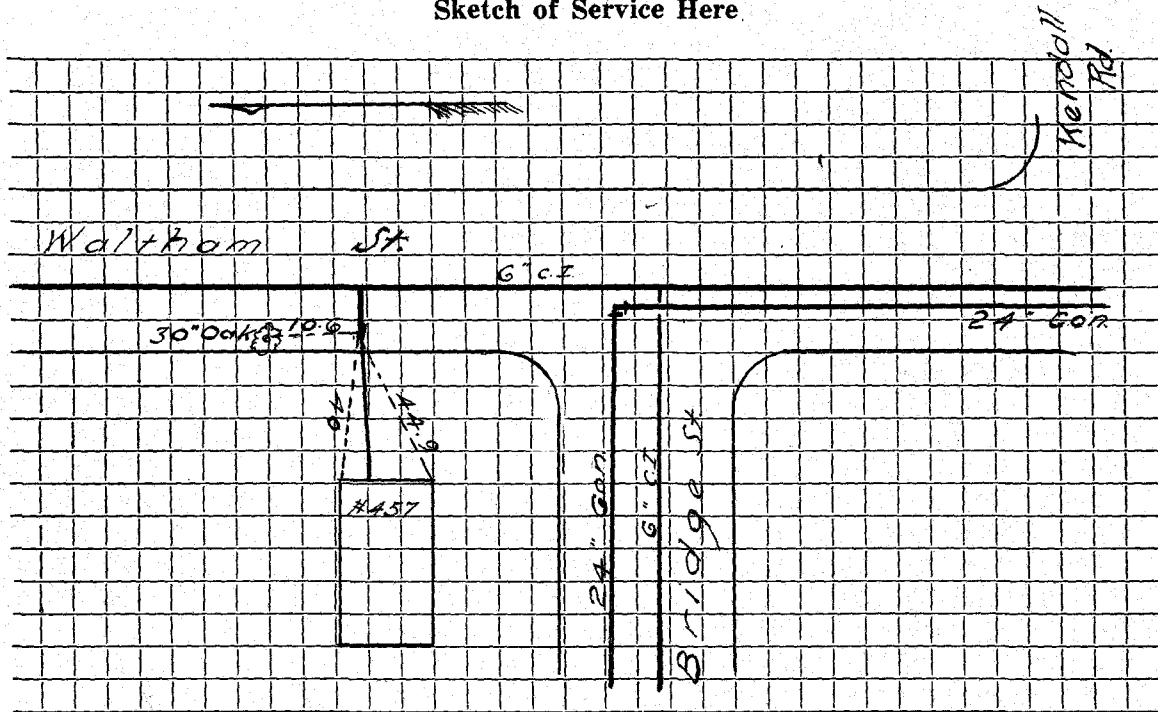

Connection made in Street. Work completed

Remarks:

.....

.....