

Name **L. A. Lindell**

WATER SERVICE RECORD

1317

Service No. 200

101

Address **471 Waltham Street**

3582

Location **Lexington**~~Repair~~ **New Service***Com. 11-13-52*


Date	Material	Amount	Total	Date	Amount
10/1/52	Labor	1 80		9-8-52	Deposited 25 00
	10% Overhead	18	1 98	11-5-52	Refunded 9 credit (7 05
	33' - 3/4" Copper tubing @.34	11 22		to S.H.C. # 137	NON CHARGE
	1 - 3/4" C x 1/2 I/W.H. stop & waste	4 00	10/1/52	Labor	1 80
	1 hr. trucking		75	5' - 3/4" Copper tubing @.34	1 70
			17 95	1 - 3/4" C. Corp-cock	4 33
				1 - 3/4" C. x 3/4" C curb-cock	4 67
				1 box and rod	3 90
				1 - 1/2 straight tail piece	50
				1 - 1/2 offset tail piece	50
				1 hr. trucking	75
					18 15

DATE _____

TOWN OF LEXINGTON — BOARD OF PUBLIC WORKS

WATER DIVISION

Sketch of Service Here

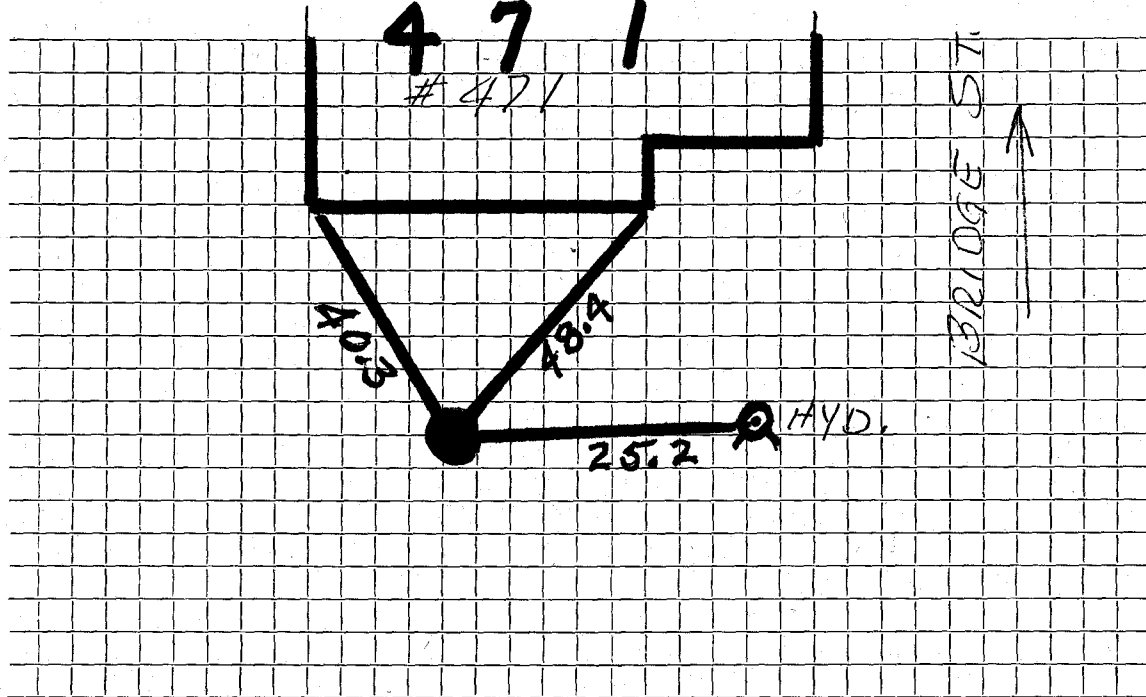

Connection made in Street. Work completed

Remarks:

.....

.....