


TOWN OF LEXINGTON - BOARD OF PUBLIC WORKS  
WATER DIVISION

Date: 9/21

SKETCH OF SERVICE HERE

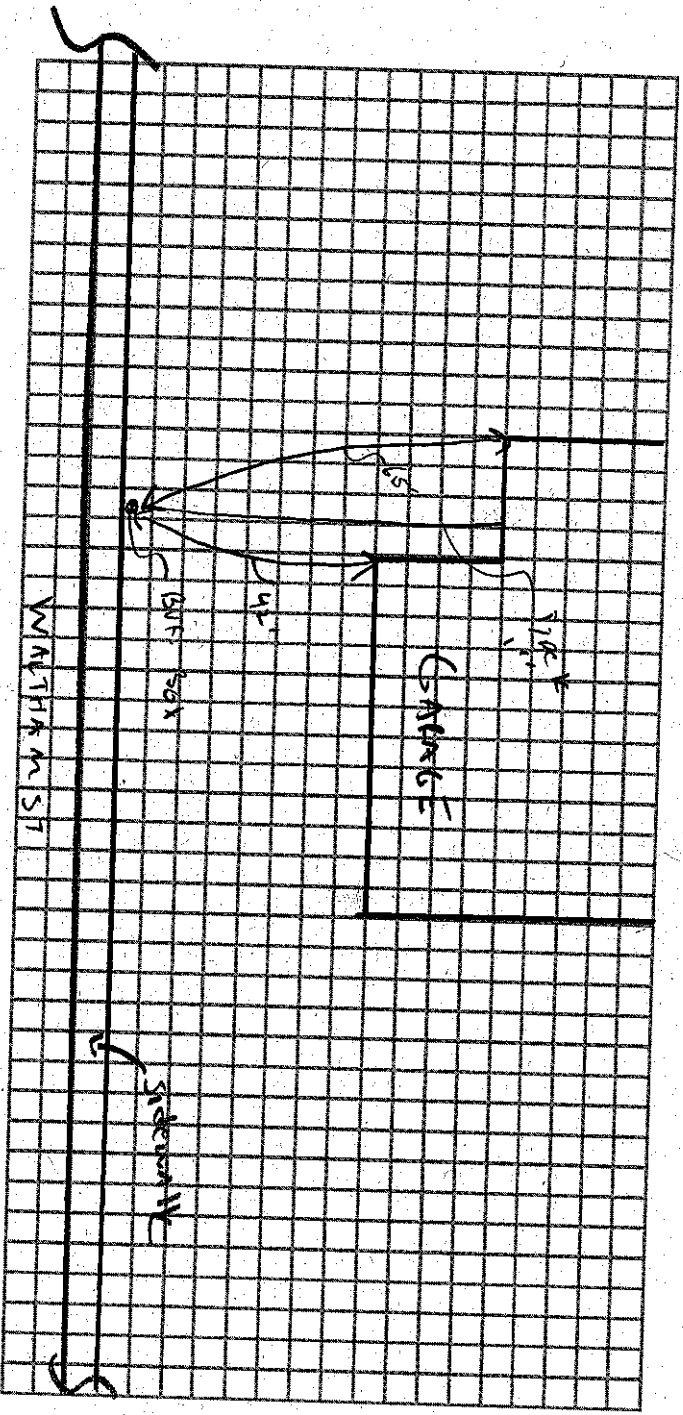

Connection made in: WALTHAM

Street:

Work completed:

Remarks:



WATER SERVICE RECORD

Name Wesley Nelson

Service No. 111

Address 483 Waltham Street

Location

~~Water Service~~ New Service W.O. #7552


Comm - 29-62

Date	Material	Amount	Total	Date	Amount	
8-21-62	Labor	15.64		8-17-62	Deposit	100.00
8-22-62	"	13.84	29.48	10-29-62	Refund	18.07
	10% O.H.	1.95	32.43			81.93
49'	3/4" Copper tubing @42		20.58			
1	3/4" Cx 1/2 I.W.H. Stop & Waste		6.17		NON CHARGE	
3	X 5 Patch		3.00	8-22-62	Labor	7.82
2 1/2	Hrs. Town Shovel @5.50		13.75	7'	3/4" Copper tubing @42	2.94
2	Hrs. Trucking @3.00		6.00	1	3/4" C Corp Cock	4.91
			81.93	1	3/4" C Curb Cock	6.28
				1	Box & Rod	4.90
				1	1/2 Straight Tailpiece	.50
				1	1/2 Offset Tailpiece	.50
				1/2	Hr. Town Shovel @5.50	2.75
						30.60

DATE \_\_\_\_\_

**TOWN OF LEXINGTON — BOARD OF PUBLIC WORKS**  
**WATER DIVISION**

Sketch of Service Here

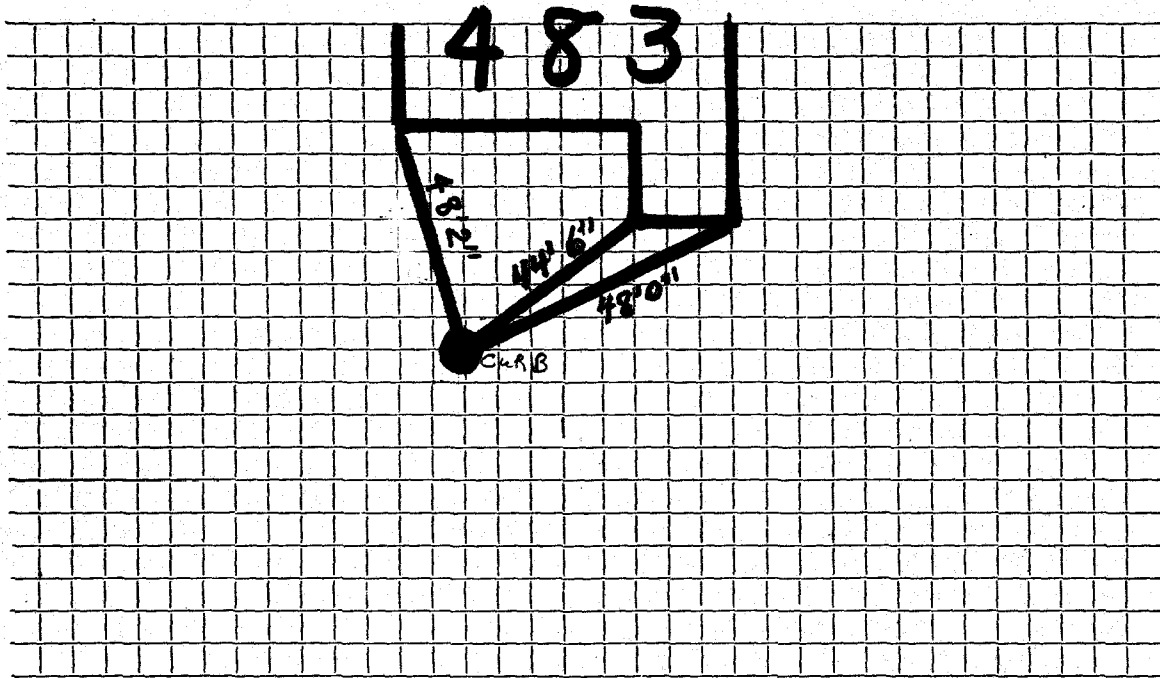

Connection made in ..... Street.                      Work completed .....

Remarks: .....  
.....  
.....