




TOWN OF LEXINGTON — BOARD OF PUBLIC WORKS


WATER DIVISION

485-487

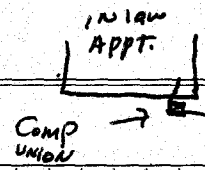

Sketch of Service Here

60' 3/4 copper dry line

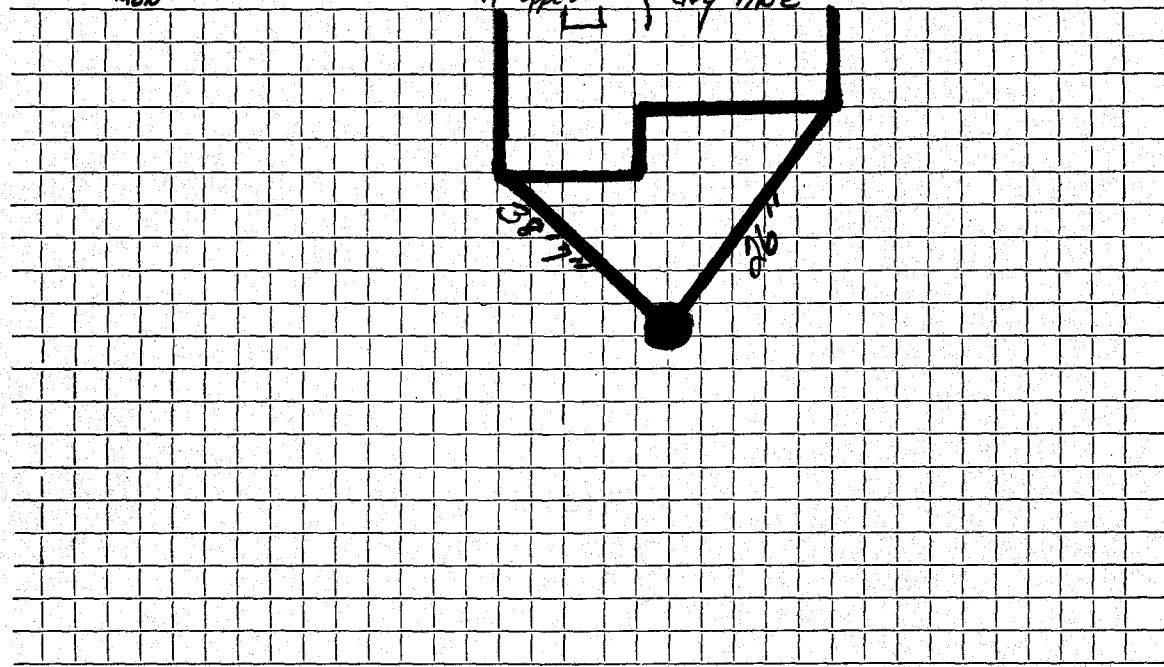

Connection made in ..... Street. Work completed .....

Remarks: .....  
.....  
.....