

WATER SERVICE RECORD

Name

Contractor: Vanavia

Service No.

Address

487 Waltham

Location

Repair—Renewal—New Service


Date	Material	Amount	Total	Date		Amount
8/8/19	1" corporation					
	1" type K copper					
	1" curb stop					
	camb. brass					
	open right					

DATE 8/8/2019

TOWN OF LEXINGTON — BOARD OF PUBLIC WORKS

WATER DIVISION

Sketch of Service Here

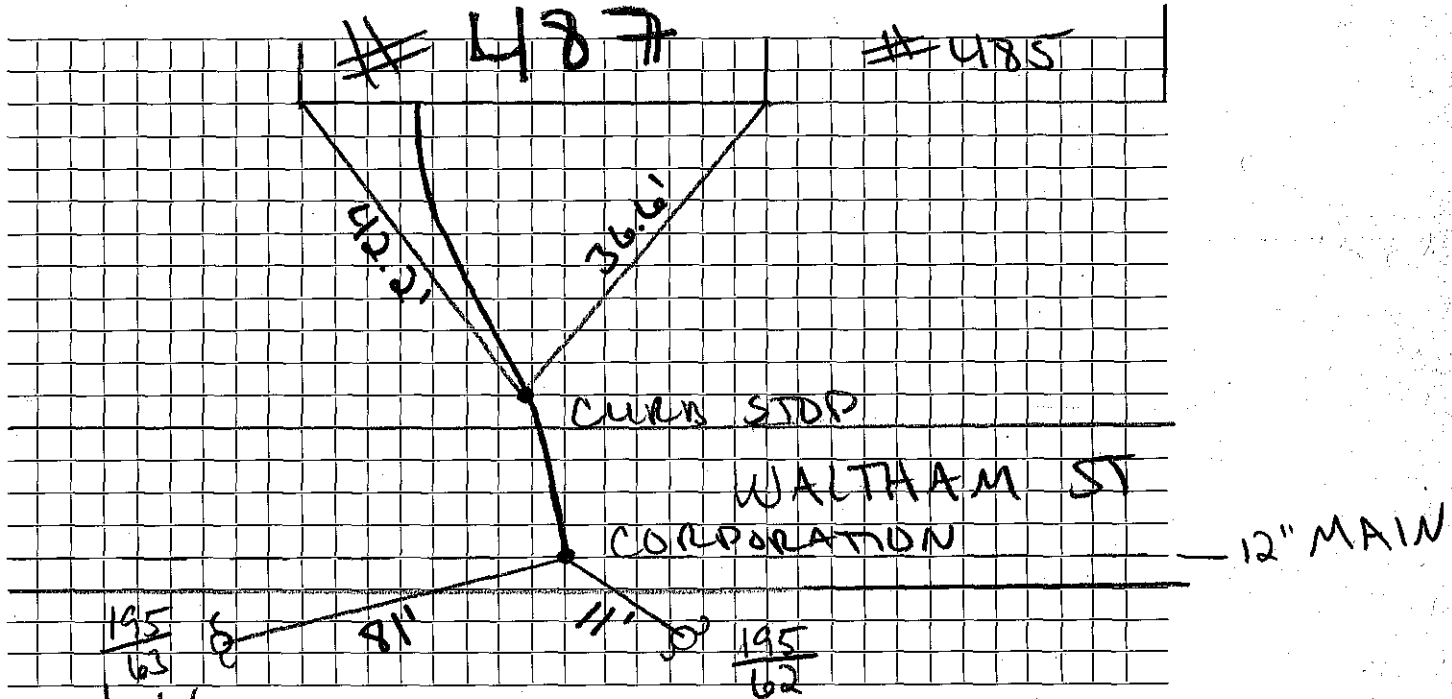

Connection made in Waltham Street. Work completed

Remarks: depth @ corp = 4.5'