

WATER SERVICE RECORD

1049

Name Nils Nillson

Service No. #41

Address 495 Waltham Street

Location

~~Repair—Renewal—NEW SERVICE~~ W.O. #7186


Comm 6-25-62

Date	Material	Amount	Total	Date	Amount
5-2-62	Labor	82.37		4-30-62	Deposit 175.00
	10% O.H.	8.24	90.61	6-25-62	Refund 41.53
557'	3/4" Copper tubing @42		23.94		133.47
1	3/4 C x 1/4 I.W.H. Stop & Waste		6.17		
1	1/2 Hrs. Town Shovel @6.50		9.75		None Charge
1	Hr. Trucking @3.00		3.00	5-2-62	Labor 7.25
			133.47	5'	3/4" Copper tubing @42 2.10
				1	3/4" C Adapter 1.90
				1	3/4" C Curb Cock 6.28
				1	Box & Rod 4.90
				1	1/2 Offset Tailpiece .50
				1	1/2 Straight Tailpiece .50
				1/2	Hr. Town Shovel @6.50 3.25
				1	Hr. Trucking @3.00 3.00
					29.68
				3/23/79	8' 3/4 COPPER
					3/4 COP.

TOWN OF LEXINGTON — BOARD OF PUBLIC WORKS

WATER DIVISION

Sketch of Service Here

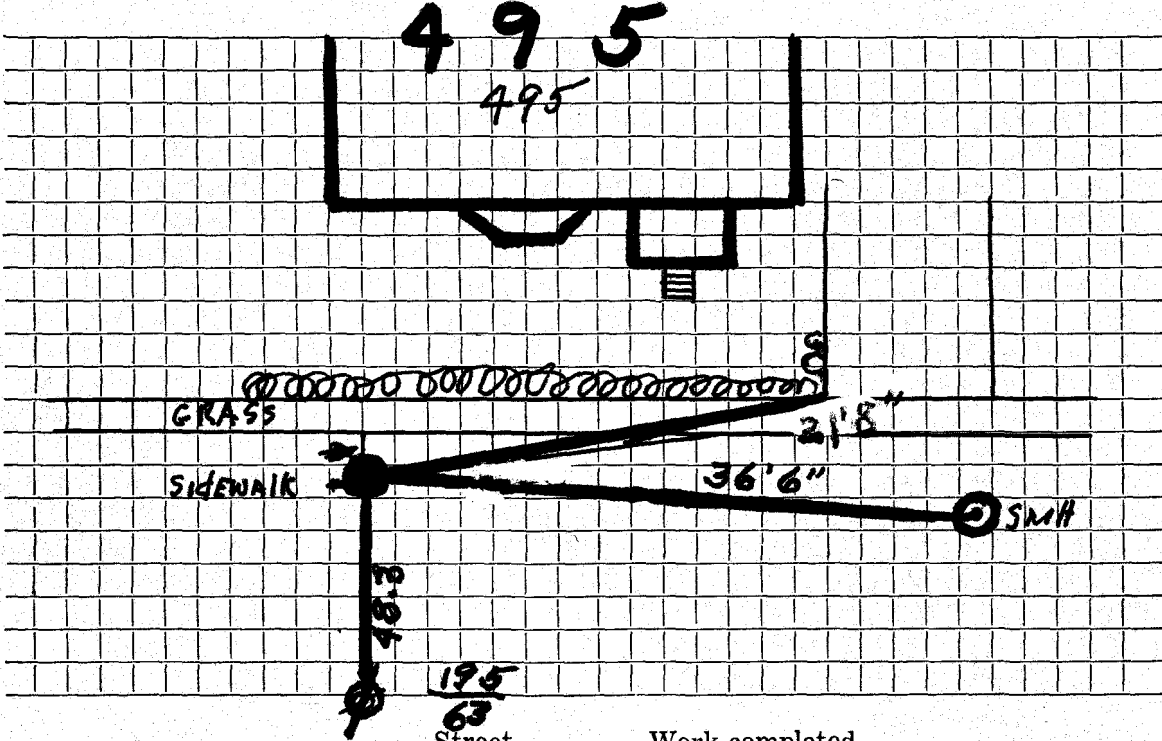

Connection made in Street. Work completed

Remarks:
.....
.....