

WATER SERVICE RECORD

Name **Mutual Enterprises**

Service No. **7**

Address **496 Waltham St.**

518

Location **Lexington**

5886

~~REPAIR WORK~~ **New Service**


COM. 2-16-53

Date	Material	Amount	Total	Date	Amount
1/23/53	Labor	14 60		1-9-53	Deposited 35 00
	10% overhead	1 46	16 06	3-2-53	Paid (10 37)
	42'-3/4" Copper Tubing @.34		14 28		NON CHARGE 85 57
	1-3/4" Cx 1/2 I.W.H. stop & Waste	4 00		1/21/53	Labor 66 61
	1-3/4" C x 3/4" C. Union (3 parts)	1 72		33'-3/4" Copper Tubing @.34	11 22
	2 Bags Rock wool @1.38		2 76	1-3/4" C. Corp-cock	4 33
	3 Hrs. Littlefield Shovel		21 00	1-3/4" Cx 3/4" C. Curb-cock	4 67
	1 Hr. Trucking		75	1-3/4" Cx 3/4" C. Union(3 parts)	1 72
	Patching 25 x 3		25 00	1-Box & Rod	3 90
			85 57	2 Bags Rockwool @1.38	2 76
				2 Hrs. #36 Compressor @2.75	5 50
				3 Hrs. Littlefield Shovel	21 00
				1 Hr Trucking	75
					122 46

DATE _____

TOWN OF LEXINGTON — BOARD OF PUBLIC WORKS

WATER DIVISION

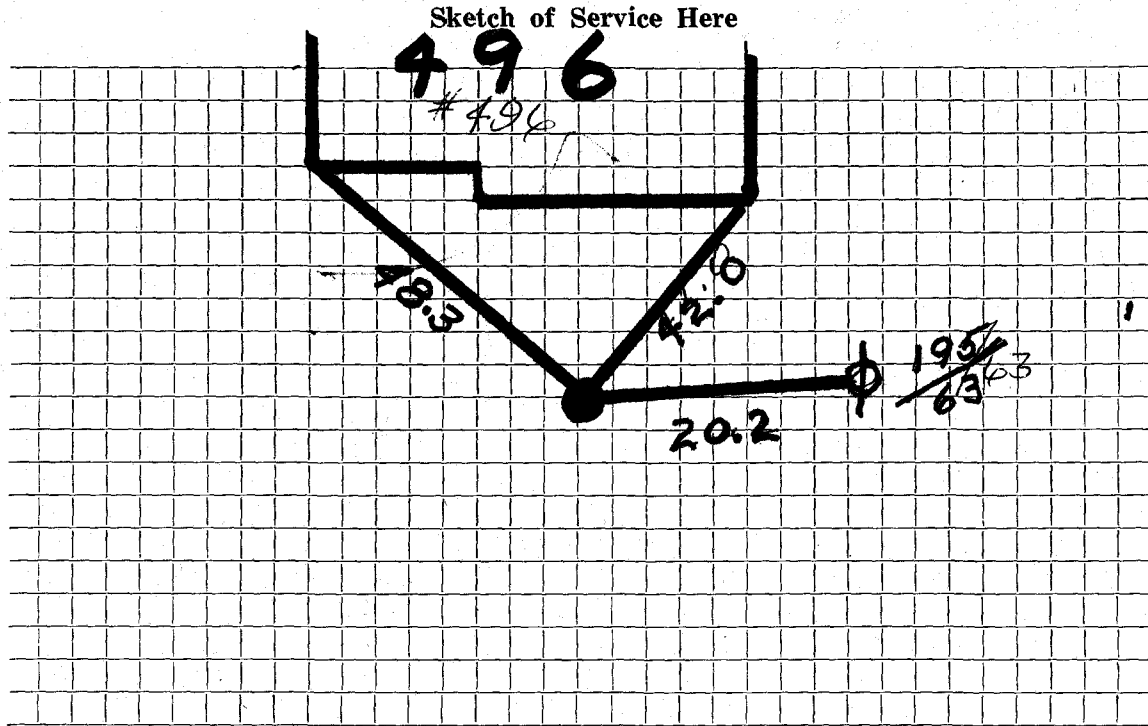

Connection made in Street. Work completed

Remarks:

.....

.....