

WATER SERVICE RECORD

Name

Service No.

Address

498 Waltham Street

2092

Location

Repair—Renewal—New Service W.O.# 8814


Date	Material	Amount	Total	Date	Amount
	COPPER INSIDE				
				8/20/70	Labor 112 08
				8/28/70	" 16 39
				21'	3/4" Copper pipe .79 16 59
					3/4" Corporation 9 57
					3/4" Curb stop 11 32
					Box & Rod 5 10
				2	Hrs. shovel 4.00 8 00
				1	" truck 3 00
				2	" compressor 4.00 8 00
					<u>190 05</u>

DATE _____

TOWN OF LEXINGTON — BOARD OF PUBLIC WORKS

WATER DIVISION

Sketch of Service Here

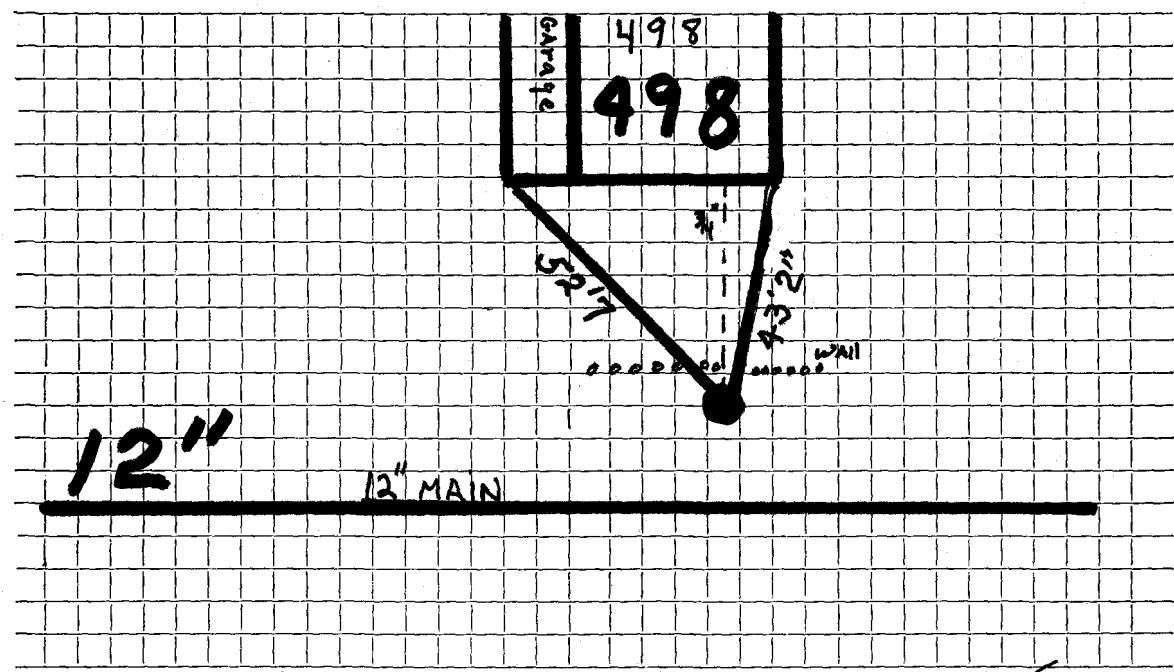

Connection made in 498 *Nat. Trans.* Street. Work completed ... 8/28

Remarks: *Money that was paid was refunded.*