

WATER SERVICE RECORD

Name

Service No.

Address

503 Waltham Street

Location

~~Repair~~—Renewal—~~New Service~~

Date		Material	Amount	Total	Date		Amount
3/29/99	58'	Lead Pipe 1" COPPER					
	1	1" FLANGE UNION					
	1	1" X 1" Comp.					
					5/24/85	12'	3/4" Copper tubing
						1	3/4" Corp Adapter
						1	3/4" Curb
						1	1" L.L. Coupling
						1	1" x 6" C.L. Nipple
						1	1" Style 30
						1	Box & Rod


DATE _____

TOWN OF LEXINGTON — BOARD OF PUBLIC WORKS

WATER DIVISION

Sketch of Service Here

503

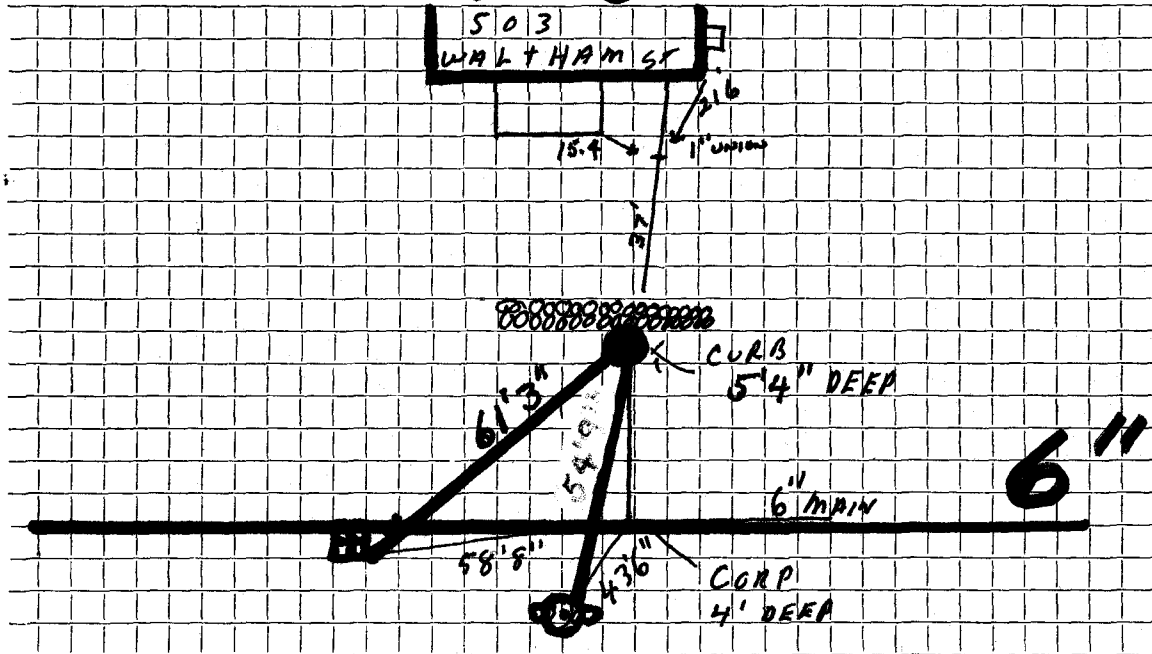

Connection made in Street. Work completed

Remarks:

.....

.....