


DATE _____

TOWN OF LEXINGTON -- BOARD OF PUBLIC WORKS

WATER DIVISION

Sketch of Service Here

504

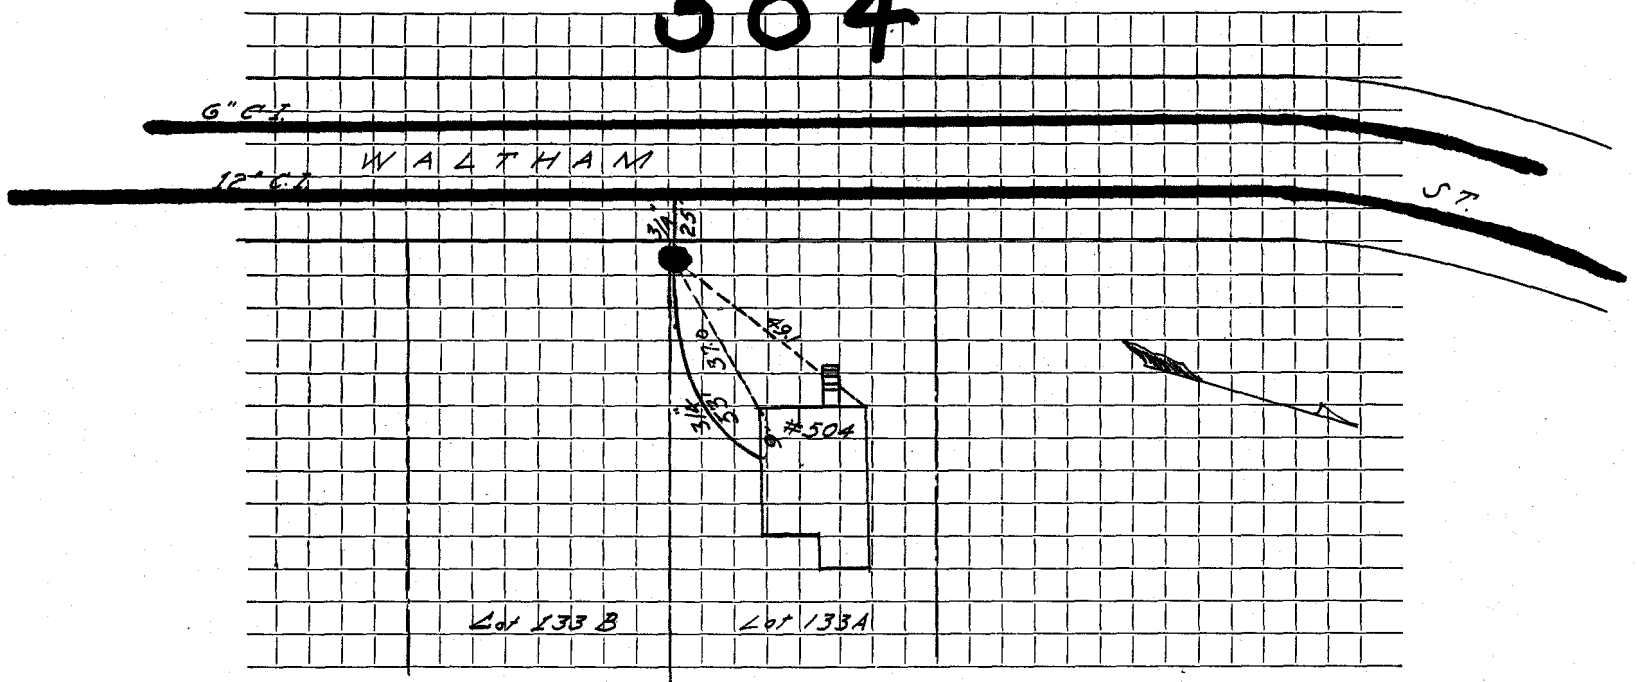

Connection made in Street. Work completed

Remarks:
.....
.....