

WATER SERVICE RECORD

Name **Martin P. O'Sullivan**

Service No. **280**

Address **510-512 Waltham Street**

Location

~~X Repair - Renewal - DISCONNECT~~

Comm. 12-31-59

Date	Material	Amount	Total	Date	Material	Amount
11-12-59	Labor	47.70		10-27-59	Deposit	125.00
	10% O.H.	4.47	52.47	12-31-59	Refused	<u>20.54</u>
	60' 1" Copper tubing @ .4676		28.06			102.16
	1 1" C x 3/4" I.W.H. Stop & Waste		6.63		NON CHARGE	
	3 hrs. Pippin @ 4.50		13.50		Labor	15.13
	2 hrs. Trucking @ .75		1.50		19' 1" Copper tubing @ .4676	8.88
			<u>102.16</u>		1 1" C Corp Cock	6.96
					1 1" C Curb Cock	7.68
					1 Box & Rod	5.00
					1 3/4" Straight Tailpiece	.50
					1 3/4" Offset tailpiece	.50
					2 hrs. Pippin Shovel @ 4.50	9.00
					10 x 3 Patch	<u>10.00</u>
						63.65

DATE _____


TOWN OF LEXINGTON — BOARD OF PUBLIC WORKS

WATER DIVISION

Sketch of Service Here

510 + 512

510 - 512

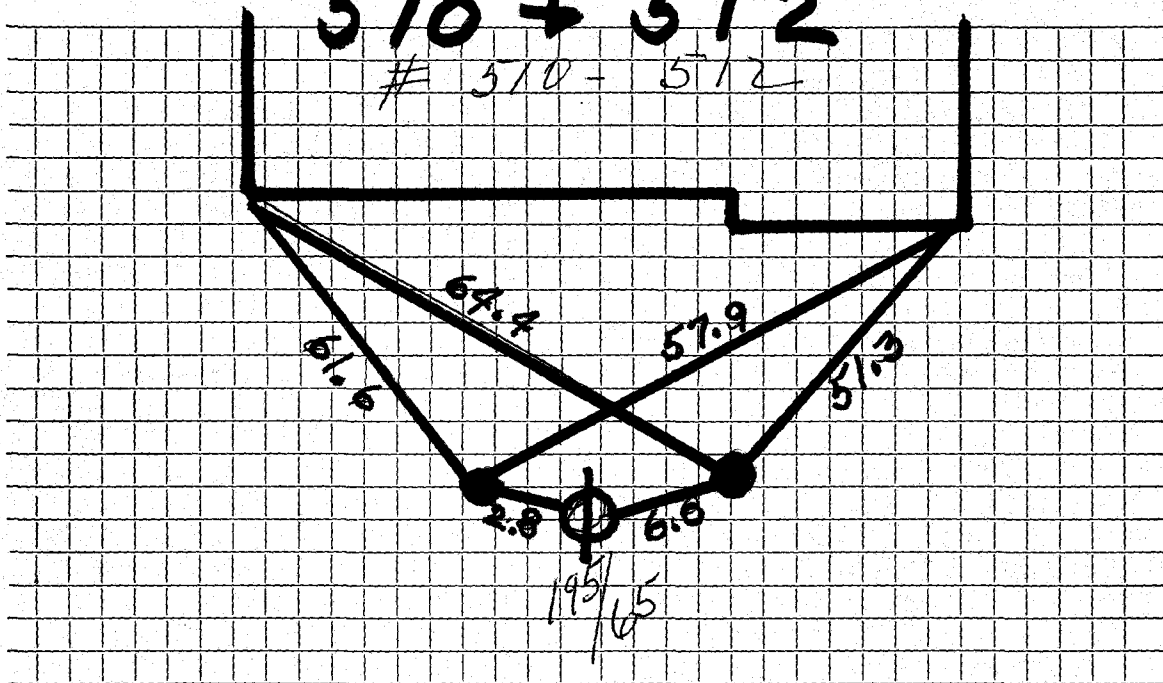

Connection made in Street. Work completed

Remarks:

.....
.....