

WATER SERVICE RECORD

356

Name Anthony Crone

Service No. 270

Address 634 Waltham Street

Location

~~X Repair - Renewal - NEW SERVICE~~


Comm 12-31-59

Date	Material	Amount	Total	Date		Amount
10-30-59	Labor	46.87		11-20-59	Deposit	150.00
	10% O.H.	4.69	51.56	12-31-59	Retained	55.57
57'	3/4" Copper tubing @.42		23.94			94.13
1	3/4" C x 1/2 I.W.H. Stop & Waste		5.88		NON CHARGE	
2 1/2	hrs Pippin Shovel @4.50		11.25		Labor	8.68
2	hrs. Trucking @.75		1.50	5'	3/4" Copper tubing.42	2.10
			94.13	1	3/4" C Corp Cock	4.67
				1	3/4" C Curb Cock	5.98
				1	Box & Rod	5.00
				1	1/2 Straight tailpiece	.50
				1	1/2 Offset tailpiece	.50
				1	1/2 hrs. Pippin Shovel@4.50	6.75
				1	hr. Trucking @.75	.75
				4	x 3 Patch	4.00
						38.93

TOWN OF LEXINGTON — BOARD OF PUBLIC WORKS

WATER DIVISION

Sketch of Service Here

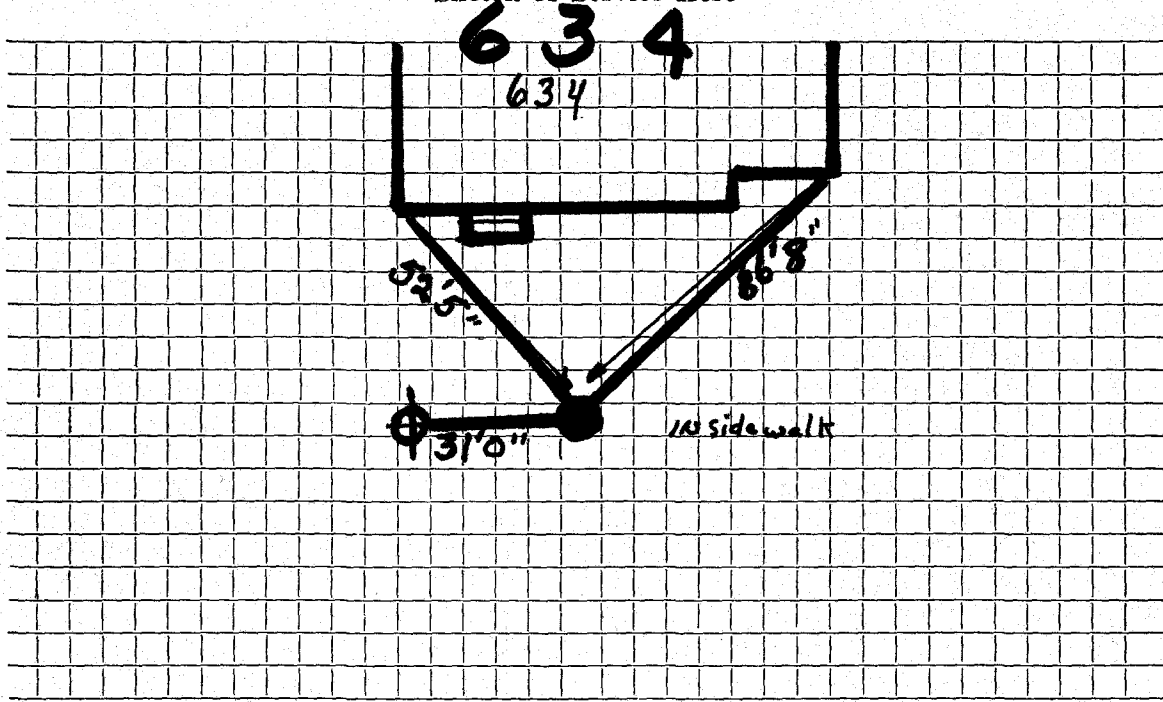

Connection made in Street. Work completed

Remarks:
.....
.....