

WATER SERVICE RECORD

Name James Catalano

Service No. 143

Address 643 Waltham Street

Location

Repair—Renewal—New Service


Com. 12-26-50

Date	Material	Amount	Total	Date	Amount
June 30, '50	Labor	15 12	15 12	June 26, '50	50 00
	10% Overhead		1 51		
	500 Sewer Brick		17 30		No Charge
	Littlefield Shovel 1 hr. @.70	7 00	7 00	June 30, '50	Labor
	Trucking 1 hr. @.75		75		5' - 2" C.L. Pipe @.45
			41 68		24' - 1" Copper Tubing @.284
					4 - 1" C Corp-cocks
					1 - 1"C x 2" I 4-way branch
					5' - 1½" C.L. Pipe
					1 - 2" T.H. Gate Valve
					1 - 2" x 1½" L.L. Red. Coupling
					1 - 1½" C.L. Nipple 6" Long
					1 - Manhole Cover & Frame
					1 - Box & Rod
					Littlefield Shovel 10 hrs. @.70
					Trucking 2 hrs. @.75
					Patching 10 x 5
					242 24

DATE \_\_\_\_\_

TOWN OF LEXINGTON — BOARD OF PUBLIC WORKS  
WATER DIVISION

Sketch of Service Here

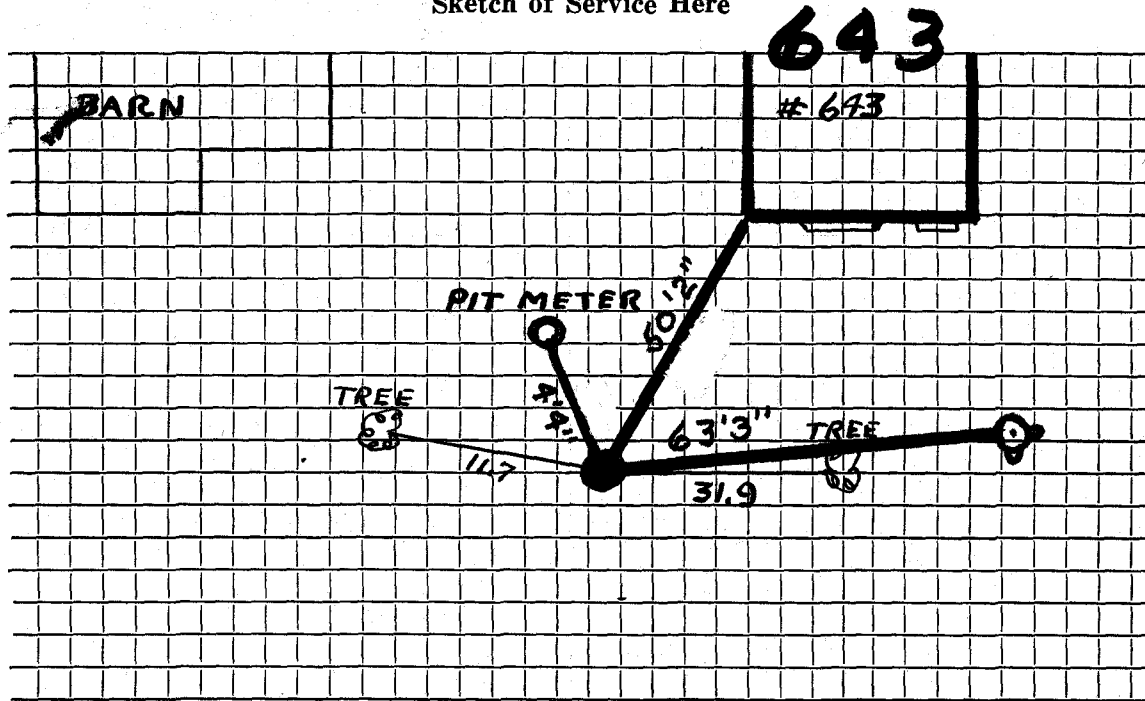

Connection made in ..... Street. Work completed .....

Remarks: .....

.....  
.....