

WATER SERVICE RECORD

Name Ted Freeman

Service No. 10

Address 672 Waltham Street

Location

~~REPAIR - REPAIR~~ New Service W.O. #2026.

Equip # 3487

FEB 10 1975

Date	Material	Amount	Total	Date	Amount
5/14/74	Labor	48 52		4-30-74	Deposit 230 00
	10 % O.H.	485	53 37	5-11-75	Refund 44 03
10'	1" Copper Tubing	@1.35	13 50		185 99
1	1" Curb Cock		16 97		NON-CHARGE
1	1" Corporation		15 17	5/21/74	Labor \$45.38
1	Box & Rod		12 95	1	Hr. Trucking @1.50 1.50
	Patch 13' x 6'		51 96	4	Hrs. Trucking @3.00 12.00
½	Ton Cold Patch	@12.20	3 05	1	Hr. Loader @4.00 4.00
2	Hrs. Trucking	@3.00	6 00	1	Hr. Compressor @5.00 5.00
2	Hrs. Town Shovel	@6.50	13 00	1	Hr. Roller @2.00 2.00
			\$185.97		\$69.88
5-30-74	90' ¾" Copper				


DATE _____

TOWN OF LEXINGTON — BOARD OF PUBLIC WORKS

WATER DIVISION

Sketch of Service Line

672 WALTHAM ST

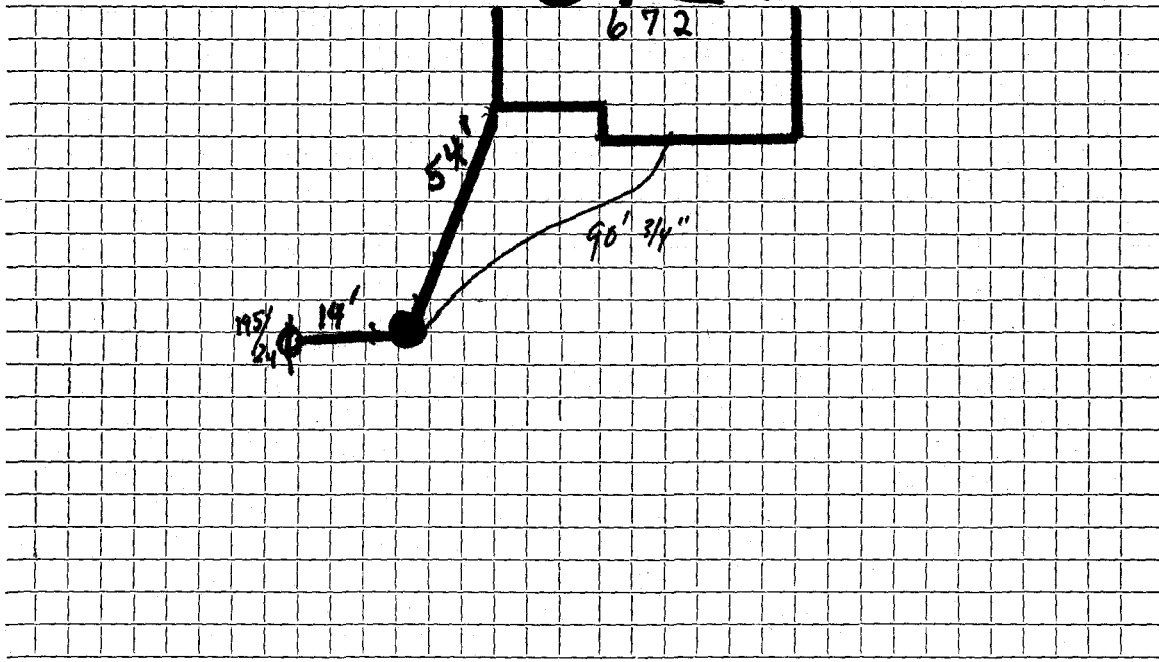

Connection made in Street. Work completed

Remarks:
.....
.....