

WATER SERVICE RECORD

Name Ted Freeman

Service No. 11

Address 674 Waltham Street

Location

~~Repair~~ ~~Renewal~~ New Service W.O. #2027. Eagle #2485

FEB 10 1975


Date	Material	Amount	Total	Date	Amount
5/16/74	Labor	48 52		4-30-74	Deposit 230 00
	10% O.H.	4 85	\$53 37	5-10-75	Retard 44 03
10'	1" Copper Tubing @1.35		13 50		185 97
1	1" Corporation		15 17		NON-CHARGE
1	1" Curb Cock		16 97	5/21/74	Labor \$45 38
1	Box & Rod		12 95	3	Hrs. Trucking @3.00 9 00
½	Ton Cold Patch @12.20		3 05	2	Hrs. Trucking @1.50 3 00
	Patch 13' x 6'		51 96	1	Hr. Roller @2.00 2 00
2	Hrs. Trucking @3.00		6 00	1	Hr. Loader @4.00 4 00
2	Hrs. Town Shovel @6.50		13 00	1	Hr. Compressor @5.00 5 00
			\$185.97		\$74 38
5-30-74	105' ¾" Copper ① Union				

DATE _____

TOWN OF LEXINGTON — BOARD OF PUBLIC WORKS

WATER DIVISION

Sketch of Service Here

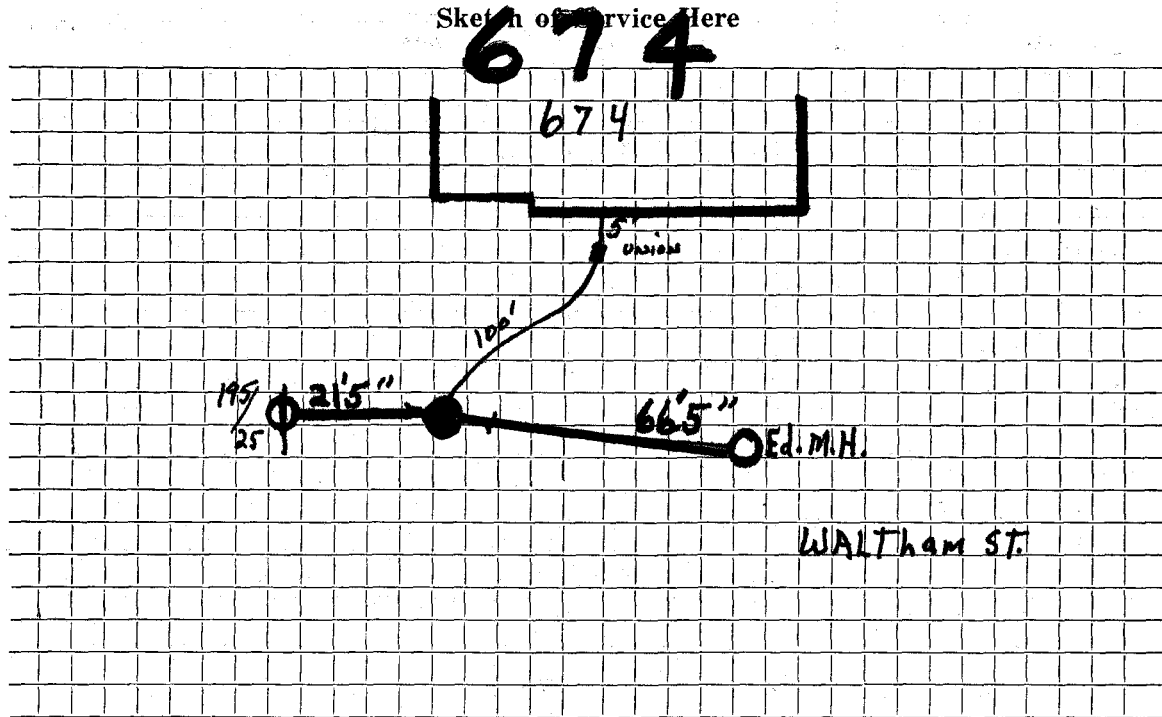

Connection made in Street. Work completed

Remarks:
.....
.....