

Name Carroll, Annie, Mary, & Letitia

Service No. # 2867

Address 676 Waltham Street

Location

Kind of Pipe

Size

Size of Main

~~Repair-Renewal~~—New Service

Location

Date	Material	Amount	Total	Date	Amount
7/3/33 9-19-33 Cum. 2.20	4 Hrs. Labor, making connection @ .55  (pipe and trenching by owner)	\$2 20		Nov. 14 1933 Abate	2 20
	Labor				

Hadley Press, Inc., Lexington

DATE June 26, 1911

# TOWN OF LEXINGTON - BOARD OF PUBLIC WORKS

## WATER DIVISION

The undersigned applies for a supply of water at No. Holtham St. and hereby agrees to comply with the rules and regulations as now, or at any future time, established by the Board of Selectmen.

Am't. of Estimate \$ \_\_\_\_\_

Owner Annie T. Mary & Letitia Carroll


Am't. Paid \$ \_\_\_\_\_

Address Allen St

Builder \_\_\_\_\_

Lexington

Sketch of Service Here

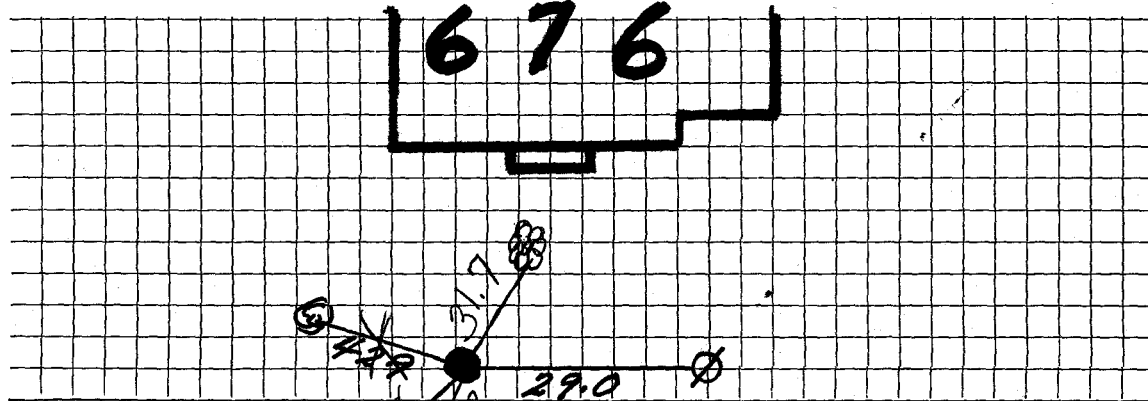

Connection made in \_\_\_\_\_ Street.

Work completed \_\_\_\_\_ 19

Remarks:

