


DATE _____

TOWN OF LEXINGTON — BOARD OF PUBLIC WORKS

WATER DIVISION

Sketch of Service Here

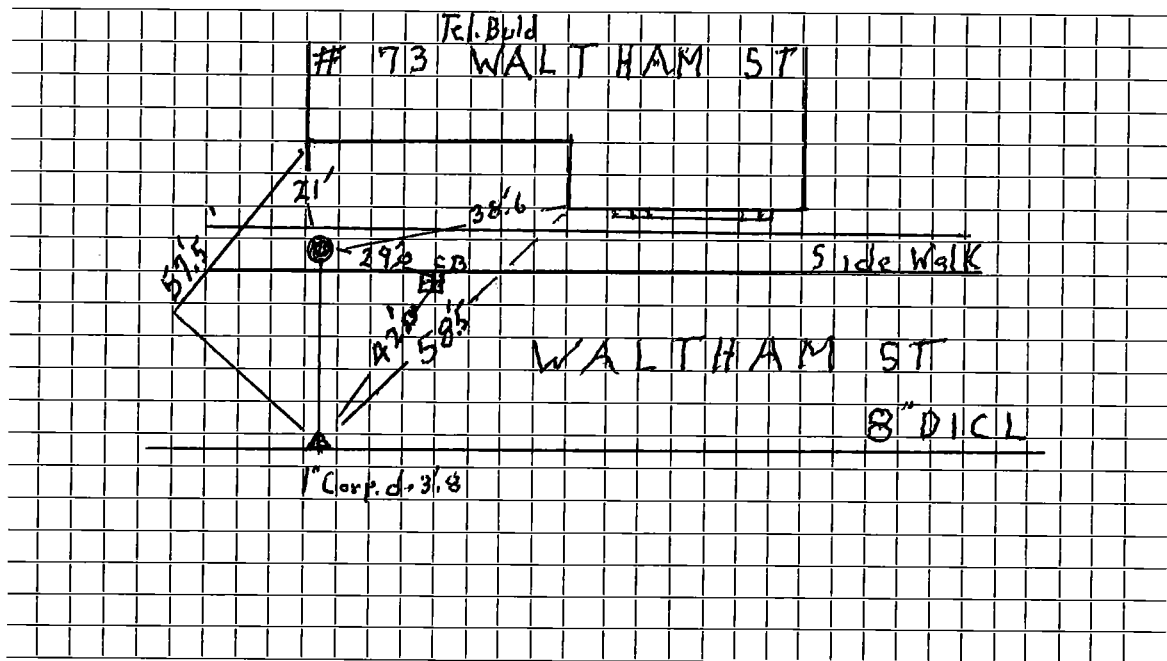

Connection made in Street. Work completed

Remarks: ... Curb down 4.5 / corp 3.8 T.O.P

... P Eng 19.12. shows 1/4 copper to build

.....