

WATER SERVICE RECORD

Name **Ralph Frissore**

Service No. **252**

Address **758 Waltham Street**

Location

~~Water~~ **New Service**

*Com. 11-9-53*

Date	Material	Amount	Total	Date	Amount
9/18/53	Labor	7 92		8-26-53	40 00
	10% overhead	79	8 71	1-12-54	10 23
	60' -3/4" copper tubing@.3629	21 77			50 23
	1 -3/4"C x 1/2 I.W.H. stop& waste	4 00			
	2 hrs. Littlefield shovel@ 7.50	15 00		9/18/53	15 00
	1 hr. trucking		75	24' - 3/4" copper tubing@.3629	8 71
			50 23	1 -3/4"C. corp-cock	4 33
				1 - 3/4Cx 3/4"C. curb-cock	4 67
				1 box and rod	3 90
				1 -1/2 straight tail pc.	50
				1 -1/2 offset tail pc.	50
				2 hrs. Littlefield shovel@ 7.50	15 00
				1 hr. trucking	75
					53 36


*Deposited*  
*Paid*  
NON CHARGE

*Bill sent 11-9-53*

TOWN OF LEXINGTON — BOARD OF PUBLIC WORKS

WATER DIVISION

Sketch of Service Here

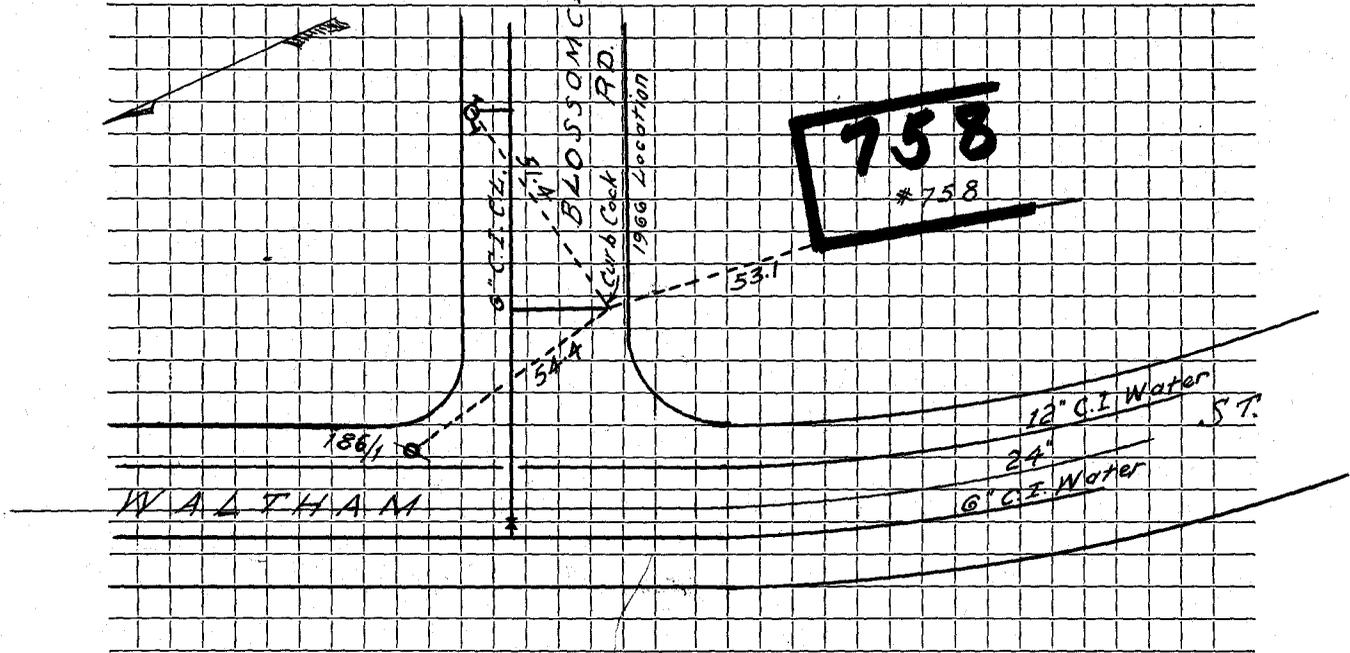

Connection made in ..... Street. Work completed .....

Remarks: .....  
.....  
.....