

U.S. 11828

WATER SERVICE RECORD

#6044

Name *Harry W. Cram*
 Address *759 Waltham St., Lexington, Mass.*
 Location

Service No. *227*


~~Repair~~ ~~Renewal~~ ~~New Service~~ *Renewal* *Comm. 12-9-57*

Date	Material	Amount	Total	Date	Amount
10-22-57	Labor	10 10		10-14-57	Deposit 75 10
	10% Overhead	1 01	11 11	12-2-57	Refund 35 28
	55'-3/4" Copper tubing @.375		20 63		\$ 39 72
	1-3/4" Cx 1/2" IWH stop & waste		4 96		NON CHARGE
	1-3/4" C 3 part Union		2 27		
	1 hr. trucking @.75		75	10-22-57	Labor 25 35
			39 72	7'-3/4" Copper tubing @.375	2 63
				1-3/4" C Corp Cock	4 64
				1-3/4" C Curb Cock	5 94
				4x3 Patch	4 00
				1 hr. Town Shovel @ 6.50	6 50
				1 hr. Trucking @.75	75
					49 81

DATE _____

TOWN OF LEXINGTON — BOARD OF PUBLIC WORKS
WATER DIVISION

Sketch of Service Here

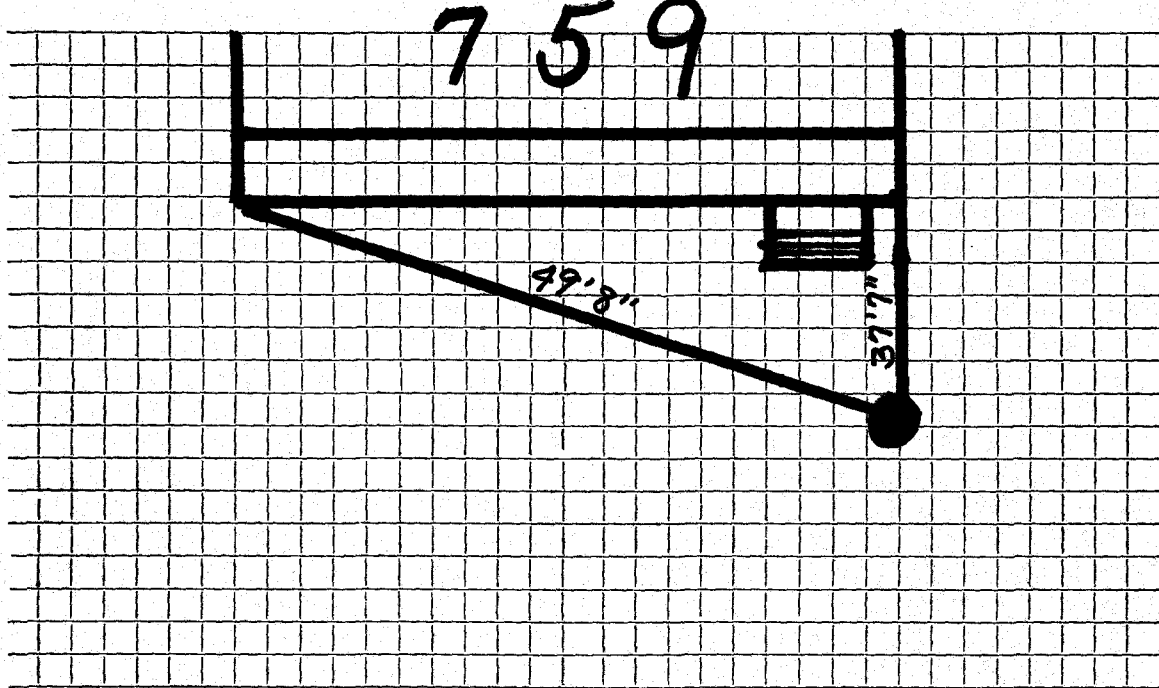

Connection made in Street. Work completed

Remarks: Original Service 6-8-29

.....
.....