

WATER SERVICE RECORD

Name Paul J. Crosby

Service No. 44

Address 800 Waltham Street

Location


~~RENEWAL~~ - Renewal - ~~NEW SERVICE~~

Comm 5-4-59

| Date | Material | Amount | Total | Date | Material | Amount |
|---------|----------------------------------|--------|-------|---------|-------------------------|--------|
| 4-13-59 | Labor | 23 05 | | 4-10-59 | Deposit | 100 00 |
| | 10% O. H. | 2 31 | 25 36 | 5-4-59 | Retard | 42 25 |
| 42' | 3/4" Copper Tubing @.3666 | | 15 40 | | | 57 85 |
| 1 | 3/4" C x 1/2 I.W.H. Stop & Waste | | 5 84 | | NON CHARGE | |
| 2 | Hrs. Trucking @.75 | | 1 50 | 4-13-59 | Labor | 11 52 |
| 1 1/2 | Hrs. Town Shovel @6.50 | | 9 75 | 21' | 3/4" Copper Tube @.3666 | 7 70 |
| | | | 57 85 | 1 | 3/4" C Corp Cock | 4 64 |
| | | | | 1 | 3/4" C Curb Cock | 6 03 |
| | | | | 1 | Box & Rod | 5 00 |
| | | | | 1 | 1/2 Straight Tailpiece | 50 |
| | | | | 1 | 1/2 Offset Tailpiece | 50 |
| | | | | 1/2 | Hr. Town Shovel @6.50 | 3 25 |
| | | | | | | 39 14 |

TOWN OF LEXINGTON — BOARD OF PUBLIC WORKS
WATER DIVISION

Sketch of Service Here

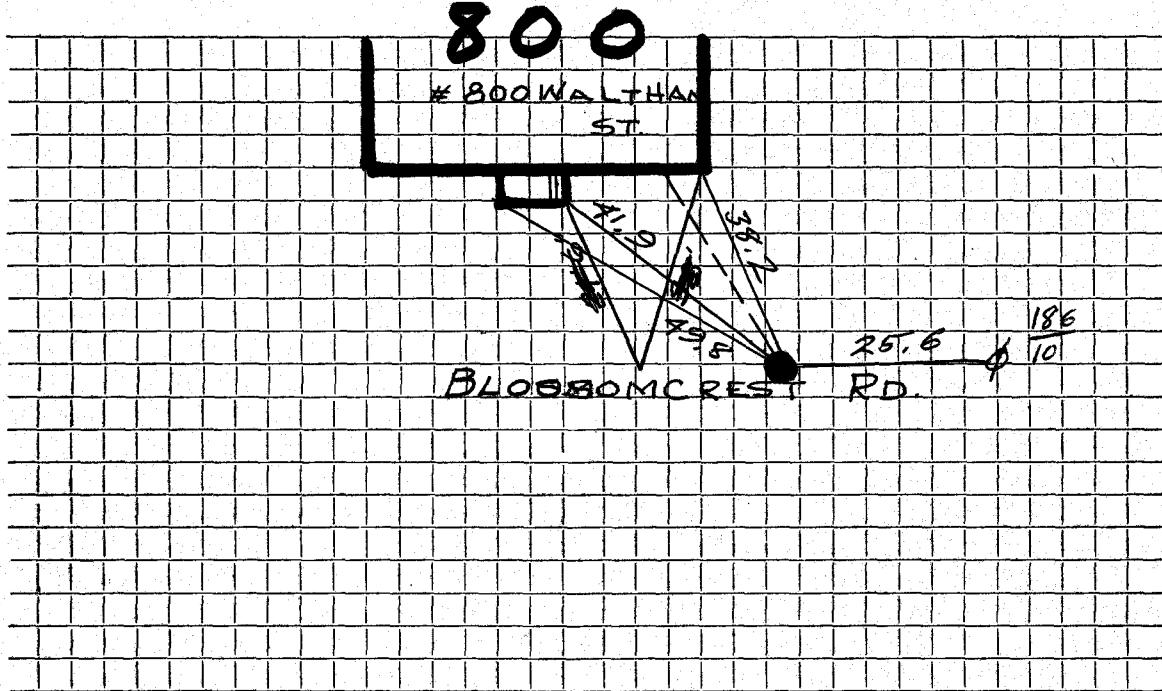

Connection made in Street. Work completed

Remarks:

.....

.....