

## WATER SERVICE RECORD

Name A. Graziano

Service No. 187

Address 80 1/2 Waltham Street

Location

~~Repair - Renewal~~ - New Service

Comm 11-16-59


Date	Material	Amount	Total	Date	Amount
8-28-59	Labor	6 21		8-18-59	Deposit 75 00
	10% O. H.	62	6 83	11-16-59	Refund 28 94
7 1/4'	3/4" Copper tubing @.41		30 34		46 06
1	3/4" C x 1/2 I.W.H. Stop & Waste		5 84		NON CHARGE
1	3/4" C 3 part Union		2 30	8-28-59	Labor 61 01
1	Hr. Trucking @.75		75	19'	3/4" Copper tubing @.41 7 79
			46 06	1	3/4" C Corp Cock 4 64
				1	3/4" C Curb Cock 5 94
				1	Box & Rod 5 00
				1	1/2 Straight Tailpiece 50
				1	1/2 Offset Tailpiece 50
				1	Hr. Town Shovel @6.50 6 50
					91 88

DATE \_\_\_\_\_

TOWN OF LEXINGTON — BOARD OF PUBLIC WORKS

WATER DIVISION

Sketch of Service Here

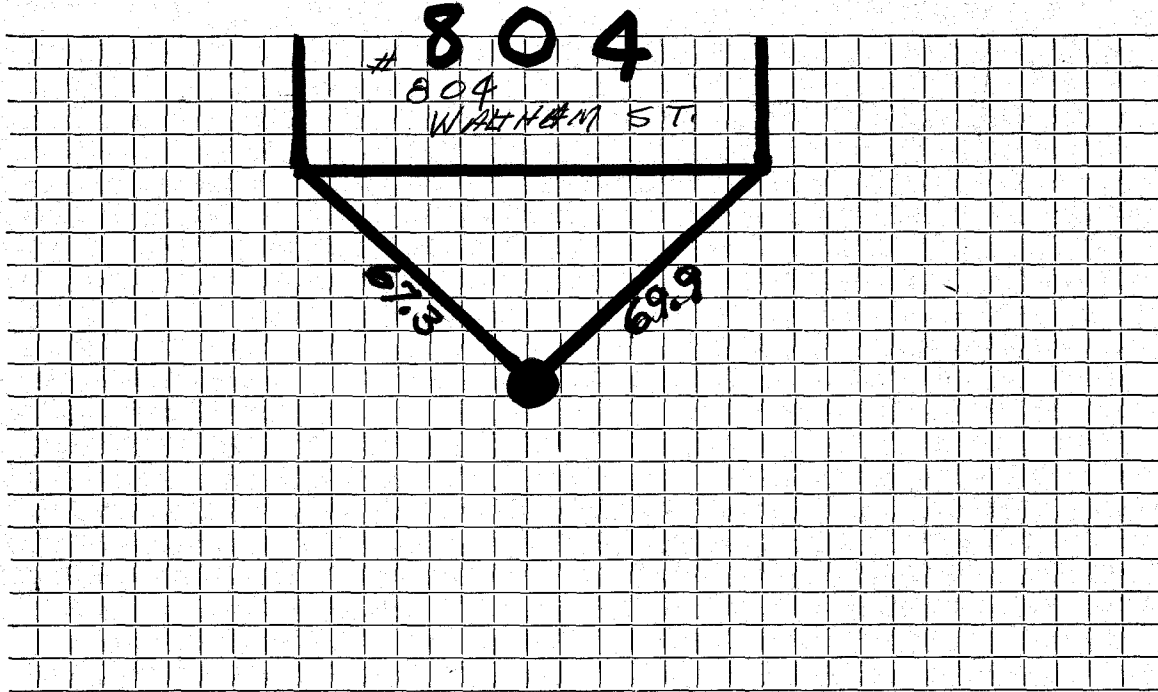

Connection made in ..... Street. Work completed .....

Remarks: .....  
.....  
.....