


DATE _____

TOWN OF LEXINGTON — BOARD OF PUBLIC WORKS

WATER DIVISION

Sketch of Service Here

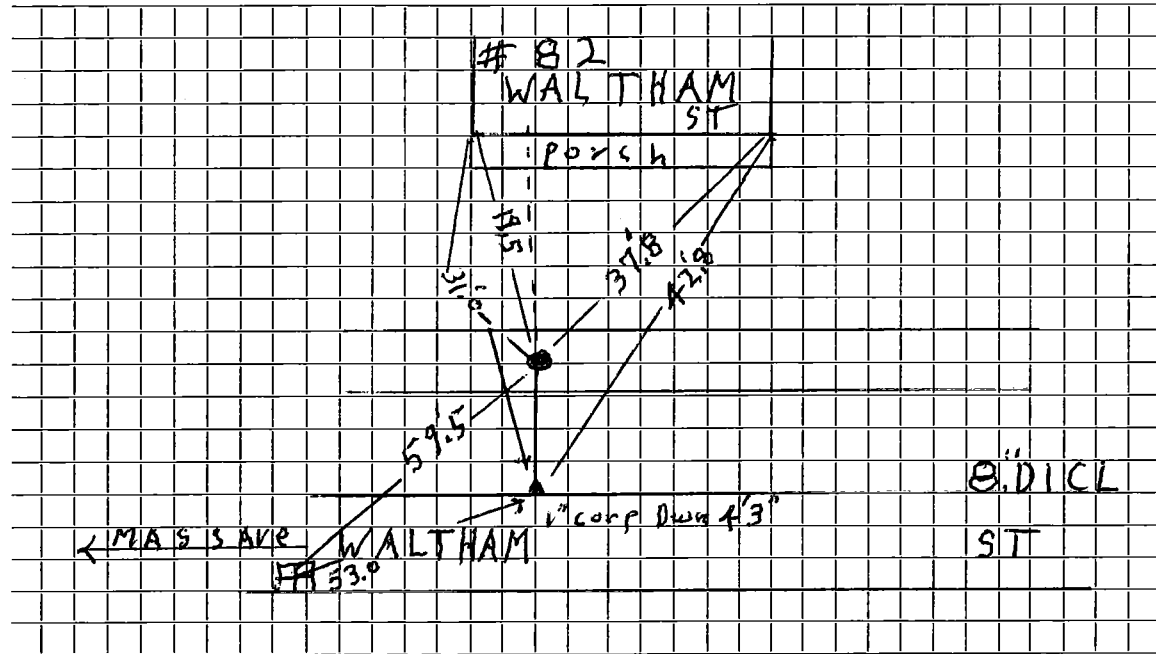

Connection made in..... Street.

Work completed 8-8-11-Gravese.....

Remarks: Curb step down 4' 4".....

.....

.....