

WATER SERVICE RECORD

Name **John Costello**

Service No. **130**

Address **837 Waltham Street**

Location

~~REPAIR~~ - Renewal - ~~REPAIR~~

Comm 12-6-61

Date	Material	Amount	Total	Date	Amount
10-7-62	Labor	2.36		9-15-62	10 00
	10% O.H.	.24	2.60	4-13-62	1 77
1	3/4" C x 1/2 I.W.H. Stop & Waste		6.17		11 77
1	hr. Trucking @3.00		3.00		
			11.77		
					NON CHARGE
				10'	3/4" Copper tubing @.42
				1	3/4" C Adapter
				1	3/4" Curb Cock
				1	1/2 Straight tailpiece
					13.19

DATE _____

TOWN OF LEXINGTON — BOARD OF PUBLIC WORKS

WATER DIVISION

Sketch of Service Here

A large grid of graph paper, approximately 20 columns wide and 25 rows high, intended for sketching service details.

Connection made in Street. Work completed

Remarks:

.....

.....

WATER SERVICE RECORD

Name John Costello

Service No. 130

Address 837 Waltham Street

Location

~~Repair~~ ~~Renewal~~ New Service Renewal

Comm 12-4-61


Date	Material	Amount	Total	Date	Amount
10-7-61	Labor	2.36		10-4-61	Deposit 10 00
	10% O.H.	.24	2.60		
	1 3/4" C x 1/2 I.W.H. Stop & Waste		6.17		
	1 hr. Trucking @3.00		3.00		NON CHARGE
9-18-28			11.77	10	3/4" Copper tubing @.42 4.20
	55' 1" C.L. Pipe			1	3/4" C Adapter 2.21
	3 1" h.h. Coup			1	3/4" Curb Cock 6.28
	1 1" h.h. ELH			1	1/2 Straight tailpiece .50
	1 1" Br. Sp. Nipple				13.19
	1 Stop + Waste				

Bill sent 127

DATE _____

TOWN OF LEXINGTON — BOARD OF PUBLIC WORKS
WATER DIVISION

Sketch of Service Here

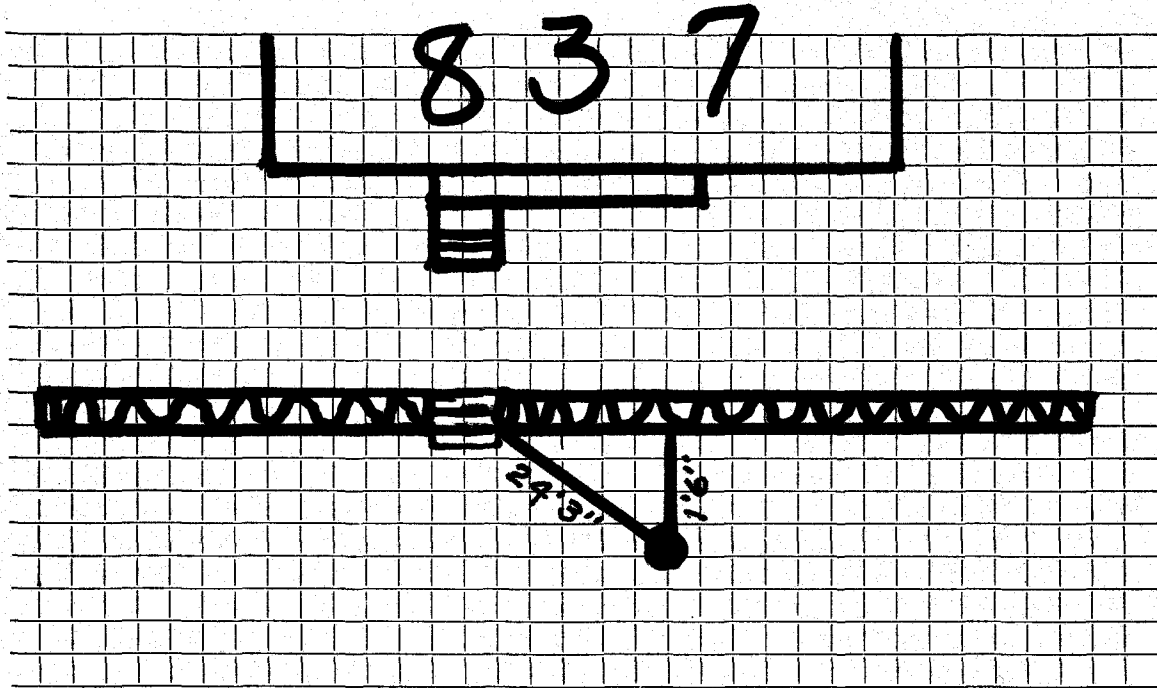

Connection made in Street. Work completed

Remarks: Original Service 9-14-28

.....
.....