

WATER SERVICE RECORD

Name Mary A. White

Service No. 86

Address 838 Waltham St.

Location Lexington

~~REPAIR & REWORK~~ - New Service

Com. 7-13-53


Date	Material	Amount	Total	Date	Amount
5/22/53	Labor	* 60 01		3-4-53	100 00
	10% overhead	6 00	66 01	7-22-53	9 63
	51'-3/4" Copper Tubing @.37		18 87		NON CHARGE
	1-3/4" C x 1/2 I.W.H. STOP & WASTE		4 00	5/25/53	Labor 37 98
	1 Hr. Trucking		75	5/26/53	Labor 56 73
	Patching 20 x 3		20 00	4-7-3/4"	Copper Tubing @.37 17 39
			109 63	1-3/4"	C Corp-cock 4 33
				1-3/4"	C x 3/4" C. Curb-cock 4 67
				1-Box & Rod	3 90
				1-1/2	Straight Tail Piece 50
				1-1/2	offset tail piece 50
				4 Hr. #36	Compressor @2.75 11 00
				5 Hr. Littlefield	Shovel@7.50 37 50
				1 Hr. Trucking	75
					<u>175 25</u>

bill sent 7-13-53

DATE _____

TOWN OF LEXINGTON — BOARD OF PUBLIC WORKS

WATER DIVISION

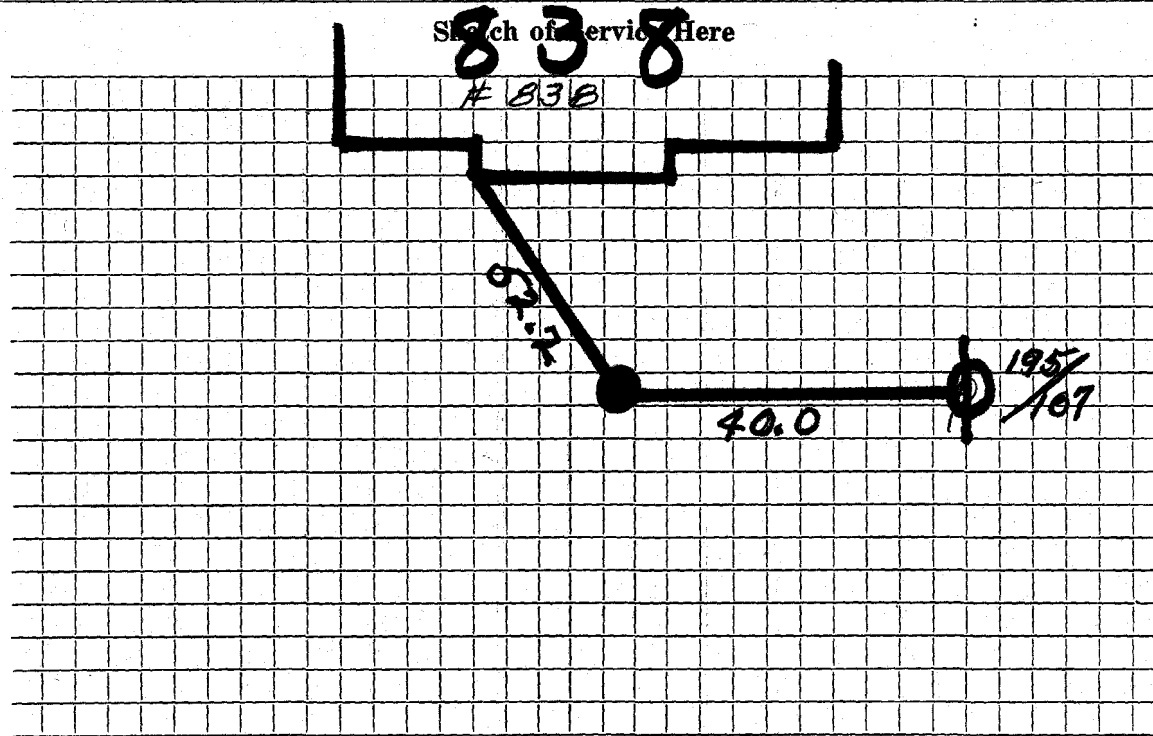

Connection made in Street. Work completed

Remarks:

.....

.....