

Name A. J. Lima

Service No. 7 2877

Address 847 Waltham Street

Location 847 Waltham St

Kind of Pipe

Size

Size of Main

~~REPAIR/RENEWAL~~ - New Service

Location

Date	Material	Amount	Total	Date	Amount
Com. 21.60 2/8/34	48' 1" Copper Pipe @.20	\$9 60		April 20, 1934 - Cash -	5 00
4/25/34	1 S & W	2 75		Aug. 17, 1934 -	16 60
	Trucking	75	\$13 10		21 60
	2 Hrs. Labor @.60	1 20	1 20		
	<u>COST</u>		\$14 30		
	<u>CHARGE</u>				
	48' @ .45 per foot	\$21 60	\$21 60		
	<u>Labor</u>				

Hadley Press, Inc. Lexington

OK 1/12/34

47' Owner does own digging & back filling
Supplies own pipe

DATE April 20, 1934

TOWN OF LEXINGTON—BOARD OF PUBLIC WORKS
WATER DIVISION

The undersigned applies for a supply of water at No. Waltham St. and hereby agrees to comply with the rules and regulations as now, or at any future time, established by the Board of Selectmen.

Am't. of Estimate \$ 5 —

Owner


A. J. Lanna

Am't. Paid \$ 5 —

Address

Builder _____

Sketch of Service Here

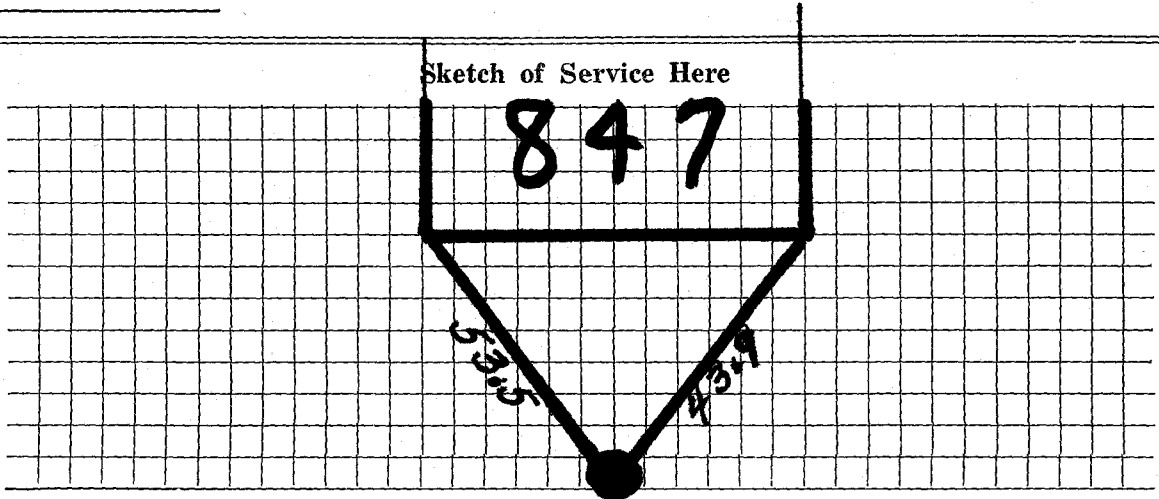

Connection made in _____ Street.

Work completed _____ 19

Remarks: