


TOWN OF LEXINGTON — BOARD OF PUBLIC WORKS

WATER DIVISION

Sketch of Service Here

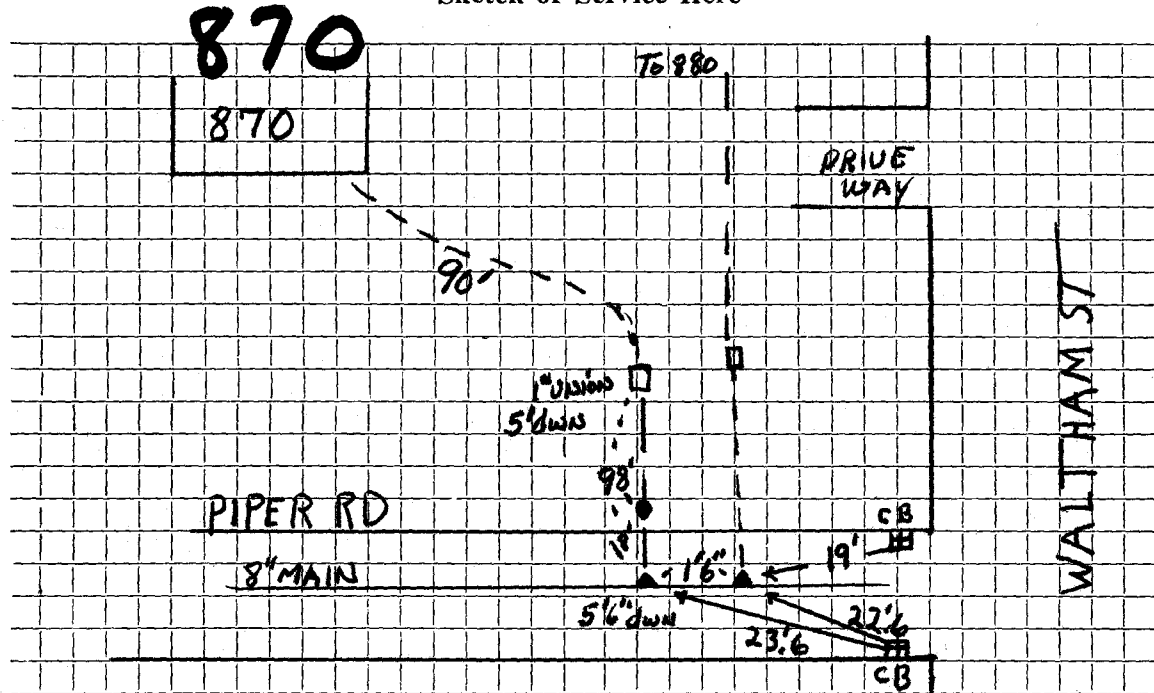

Connection made in PIPER RD Street. Work completed

Remarks: BOTH SERVICES IN SAME TRENCH FOR 15.7' FROM CURB BOX THEN SPLIT