

WATER SERVICE RECORD

Name **Carmine Nardone**Service No. **309 (1956)**Address **877-879 Waltham Street**

Location


~~Repair~~—Renewal—~~New Service~~*Comm. 2-25-57*

Date	Material	Amount	Total	Date	Amount
10/29/56	Labor	48 53		10-8-56	Deposit \$ 300 00
10/31/56	"	20 53		9-8-57	Paid <u>68 00</u>
		69 06			NON CHARGE 368 00
	10% overhead	6 90	75 96	10/30/56	Labor 20 80
	310' - 1" Copper tubing @ .6150	190 65		10' - 1" Copper tubing @ .6150	6 15
	3 - 1" Unions (3 part) @ 3.12	9 36		3 - 1" C. Curb Cocks @ 6.49	19 47
	2 - 1" I.W.H. Stop & Waste @ 5.60	11 20		3 Box & Rods @ 4.62	13 86
	2 hrs. Trucking @ .75	1 50		1 - 1" C. Corp Cock	5 61
	9 1/3 hrs. Littlefield Shovel @			4 hrs. Littlefield Shovel @ 8.50	<u>34 00</u>
		8.50	79 33		99 89
			368 00		

Bill sent 2-27-57

TOWN OF LEXINGTON — BOARD OF PUBLIC WORKS

WATER DIVISION

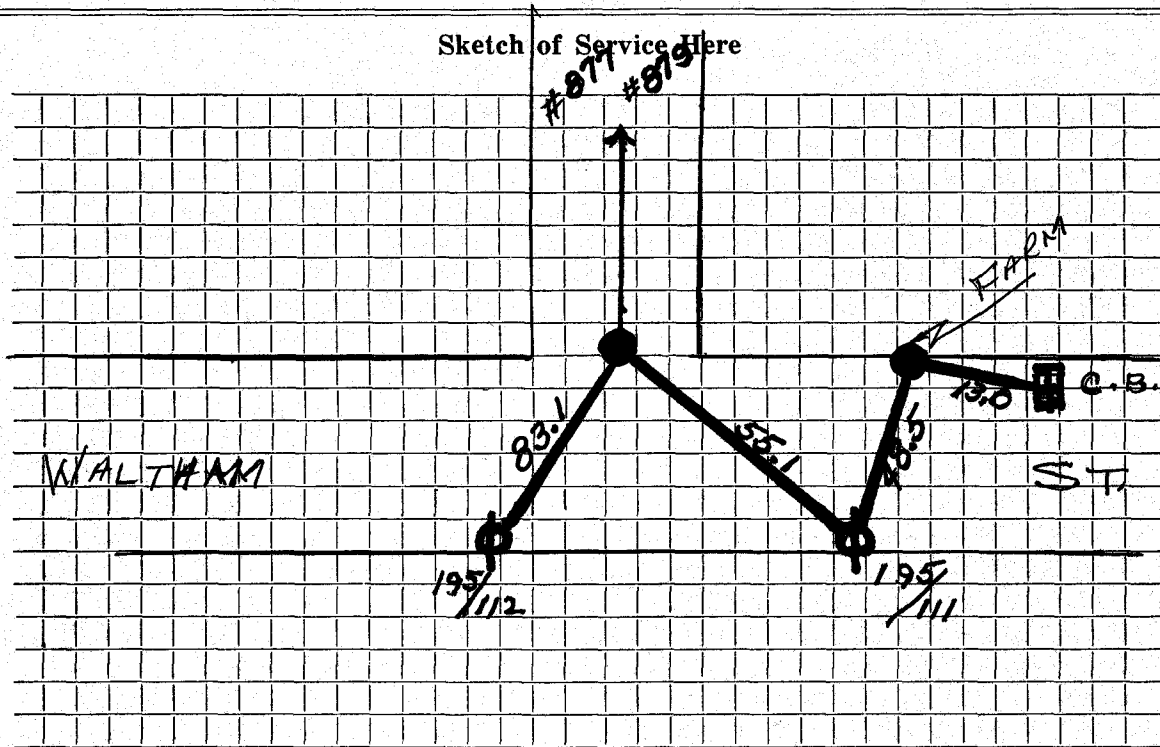

Connection made in Street. Work completed

Remarks:

.....


.....

DATE _____

TOWN OF LEXINGTON — BOARD OF PUBLIC WORKS

WATER DIVISION

Sketch of Service Here

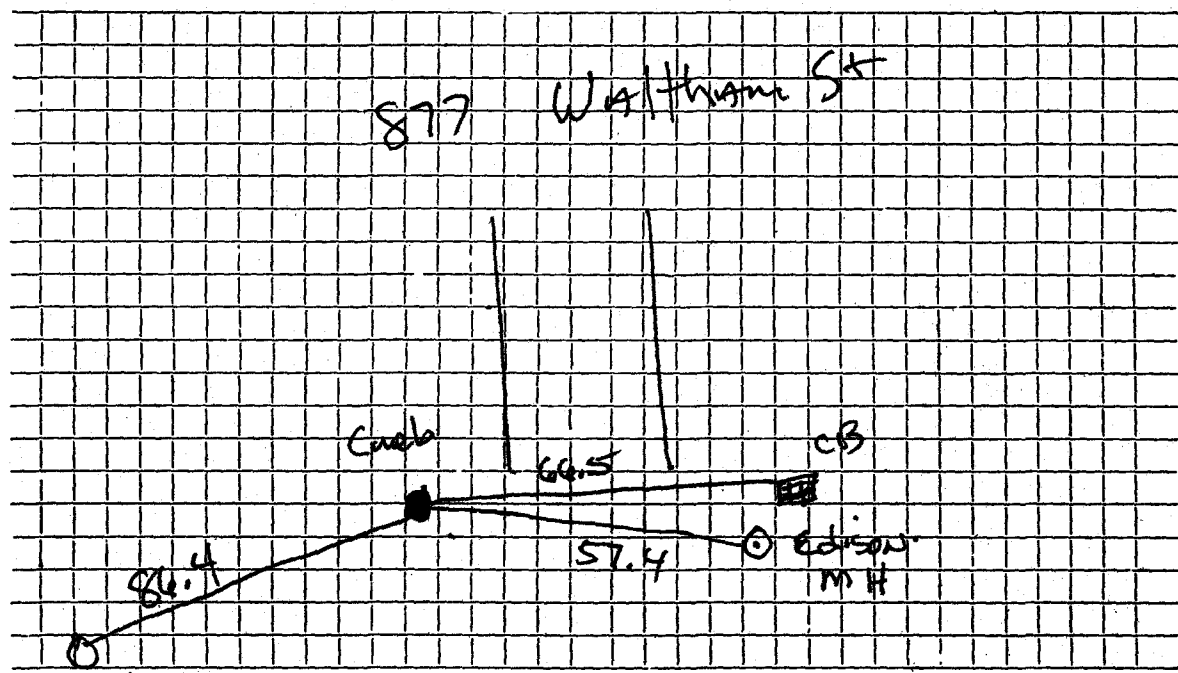

Connection made in Street. Work completed

Remarks:

.....

.....

