




DATE \_\_\_\_\_

# TOWN OF LEXINGTON — BOARD OF PUBLIC WORKS

## WATER DIVISION

Sketch of Service Here

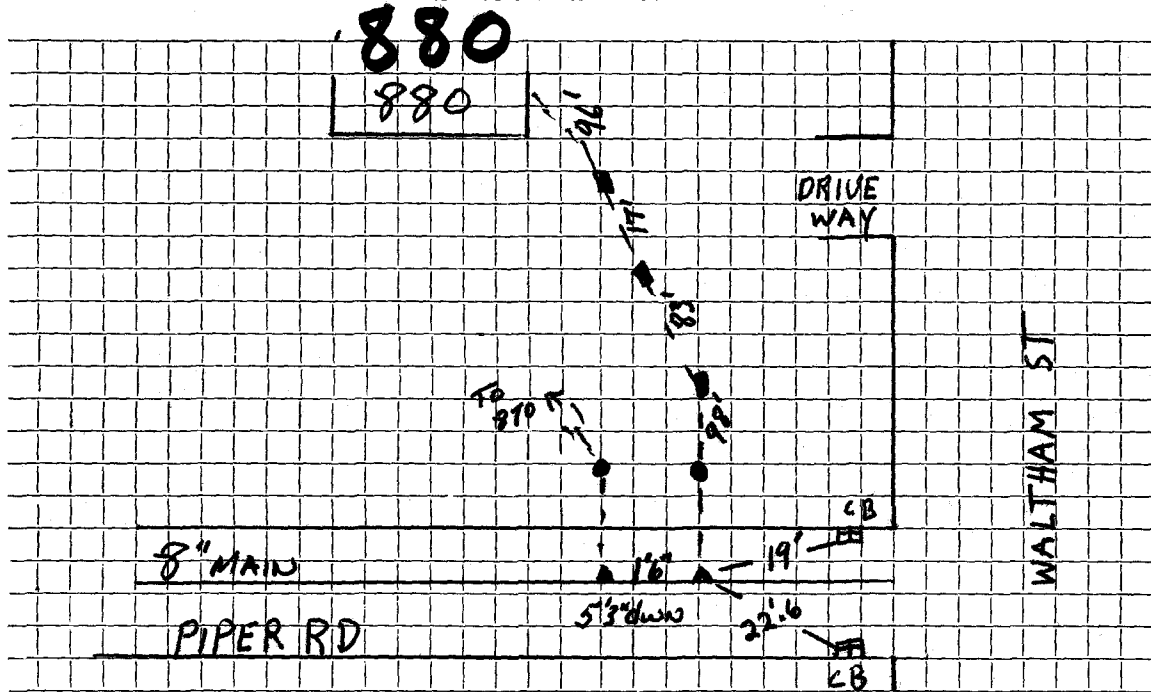

Connection made in PIPER RD Street. Work completed .....

Remarks: Services in SAME Trench For 157' Then SPLIT. .....