

WATER SERVICE RECORD

Name Herman Ericson

Service No. 13

Address 890 Waltham St. Lexington, Mass.

Location

~~Repair - Renewal~~ - New Service WO #4241


Date	Material	Amount	Total	Date	Amount
4/28/76	labor	236. 92		4/9/76	Deposit 3,000. 00
	10%OH	23. 70	260. 62	8/16/76	Refund 1408. 69
60'	1" copper tubing @ .83		49. 80		591. 31
1	1" corp.		16. 69		
1	1" curb stop		18. 67		
1	box and rod		15. 92		
3	yds. gravel @ 2.19		6. 57		
3	tons cold patch @ 13.75		41. 25		
4	hrs. town shovel @ 6.50		26. 00		
5	hrs. compressor @ 5.00		25. 00		
2	hrs. truck @ 3.00		6. 00		
	5 X 6 patch sidewalk		19. 98		
	30 X 3 patch street		93. 30		
2½	yds. loam @ 4.50		11. 25		
2	lbs. grasseed @ .39		. 78		
			591. 31		

DATE 6/15/94

TOWN OF LEXINGTON — BOARD OF PUBLIC WORKS

WATER DIVISION

Sketch of Service Here

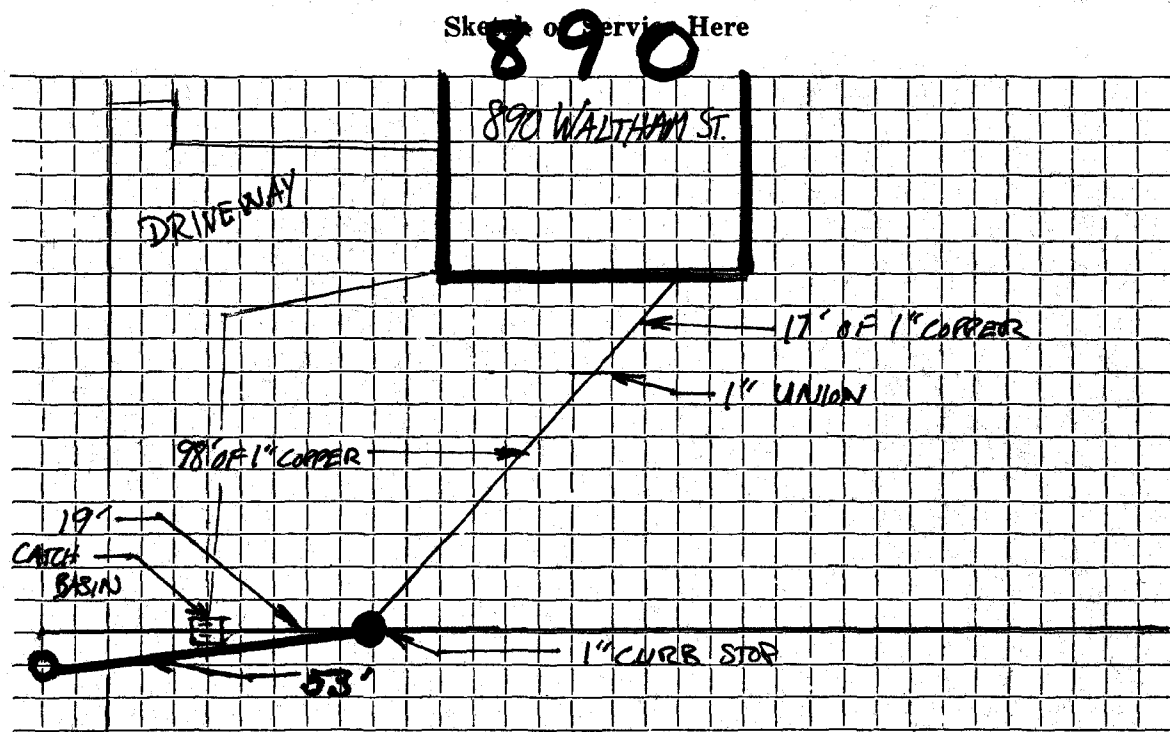

Connection made in Street. Work completed

Remarks:

.....

.....

WATER SERVICE RECORD

Name Herman Ericson

Service No. 13

Address 890 Waltham St. Lexington, Mass.

Location

~~Repair - Renewal~~ - New Service WO #4241


Date	Material	Amount	Total	Date	Amount
4/28/76	labor	236. 92		4/9/76	Deposit 2,000. 00
	10%OH	23. 70	260. 62	8/10/76	Refund 1408. 69
	60' 1" copper tubing @ .83		49. 80		591. 31
	1 1" corp.		16. 69		
	1 1" curb stop		18. 67		
	1 box and rod		15. 92		
	3 yds. gravel @ 2.19		6. 57		
	3 tons cold patch @ 13.75		41. 25		
	4 hrs. town shovel @ 6.50		26. 00		
	5 hrs. compressor @ 5.00		25. 00		
	2 hrs. truck @ 3.00		6. 00		
	5 X 6 patch sidewalk		19. 98		
	30 X 3 patch street		93. 30		
	2½ yds. loam @ 4.50		11. 25		
	2 lbs. .grasseed @ .39		. 78		
			591. 31		

DATE _____

TOWN OF LEXINGTON — BOARD OF PUBLIC WORKS

WATER DIVISION

Sketch of Service Here

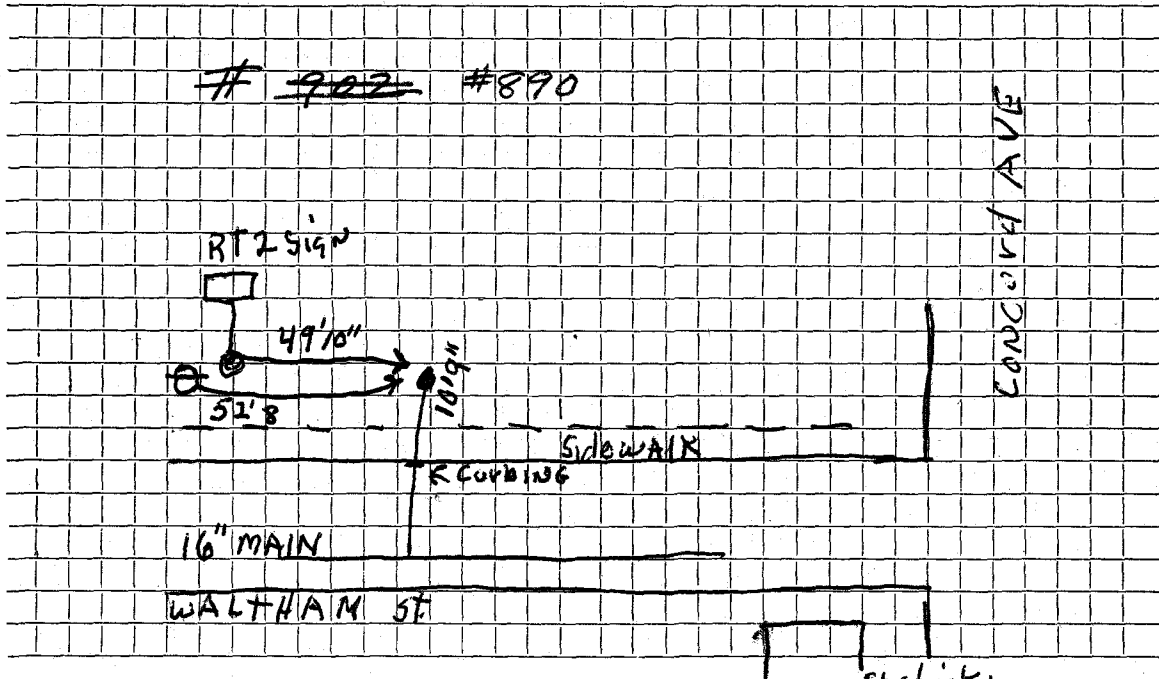

Connection made in Street. Work completed Chadwick's


Remarks:
.....
.....

DATE 6/15/94

TOWN OF LEXINGTON — BOARD OF PUBLIC WORKS

WATER DIVISION

Sketch of Service Here

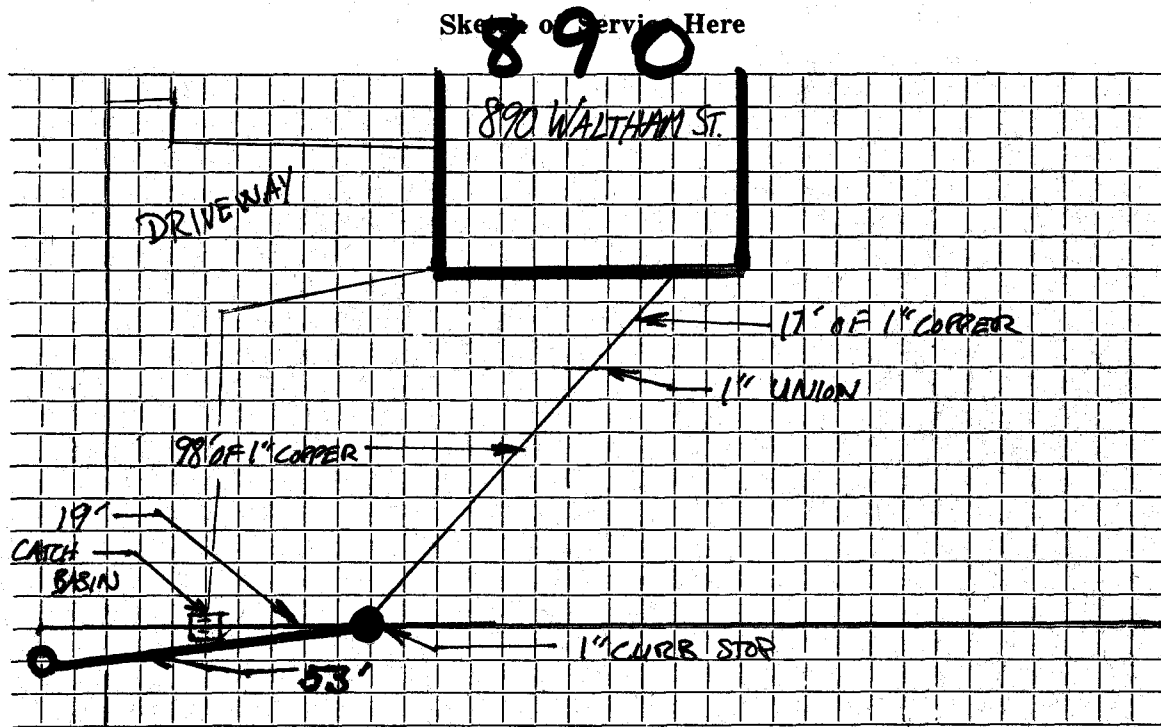

Connection made in Street. Work completed

Remarks:

.....

.....