

WATER SERVICE RECORD

Name William Hardy

Service No. 64

Address 903 Waltham Street

Location

~~X~~ ~~NEW SERVICE~~ — New Service

WO #7320


Comm 2-16-63

Date	Material	Amount	Total	Date	Amount	
6/4/62	Labor	39 88		5-24-62	Deposit	200 00
	10% O.H.	3 99	43 87	7-16-62	Refund	112 17
	38' 1" Copper Tubing @ .56		21 28			87 86
	1 1" X 1" IWH Stop & Waste		6 96			
	1 1/2 Hrs. Town Shovel @ 6.50		9 75			
	2 Hrs. Trucking @ 3.00		6 00		Curb to Main	
			87 86	6/4/62	Labor	7 35
					7 1" Copper Tubing @ .56	3 92
					1 1" C Corp Cock	7 31
					1 1" C Curb Cock	8 06
					1 Bow & Rod	4 90
					1 1" Straight Tailpiece	93
					1 1" Offset Tailpiece	93
					1/2 Hr. Town Shovel @ 6.50	3 25
						36 65

DATE _____

TOWN OF LEXINGTON — BOARD OF PUBLIC WORKS

WATER DIVISION

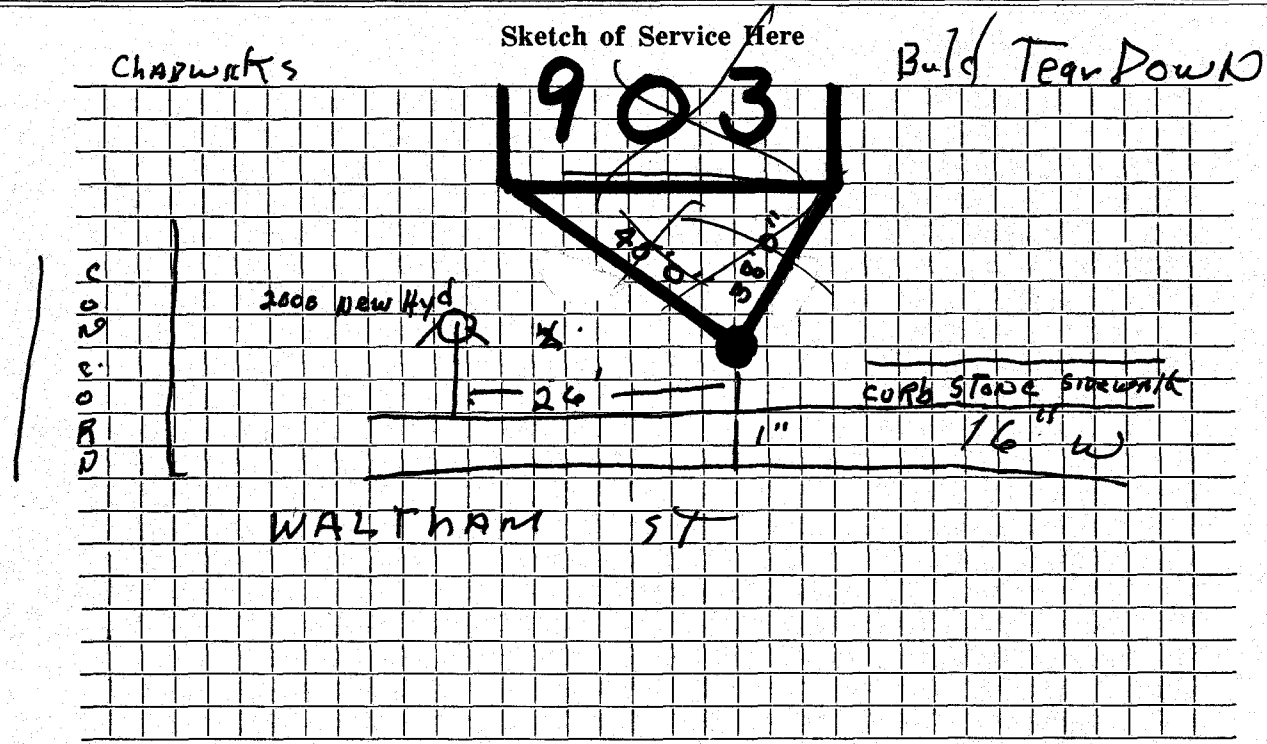

Connection made in Street. Work completed

Remarks:
.....
.....