

WATER SERVICE RECORD

Name

Service No.

Address 915 Waltham Street (Gas Station)

Location

Repair—Renewal—New Service W.O. #211


Date		Material	Amount	Total	Date	Amount
		CURB TO MAIN				
4-29-65		Labor	44 98			
		10% O.H.	4 50	49 48		
	8'	3/4" copper tubing @ .42		3 36		
	1	3/4" Curb		8 76		
	1	Adapter		2 76		
	1	1" lead lined coup.		60		
	1	Box & Rod		4 90		
	2	Hrs. Town Shovel @ 6.50		13 00		
	2	Hrs. Town Truck @ 3.00		6 00		
				<u>88 86</u>		
10/26/66	74'	1" Copper tubing				

DATE \_\_\_\_\_

# TOWN OF LEXINGTON — BOARD OF PUBLIC WORKS

## WATER DIVISION

Sketch of Service Here

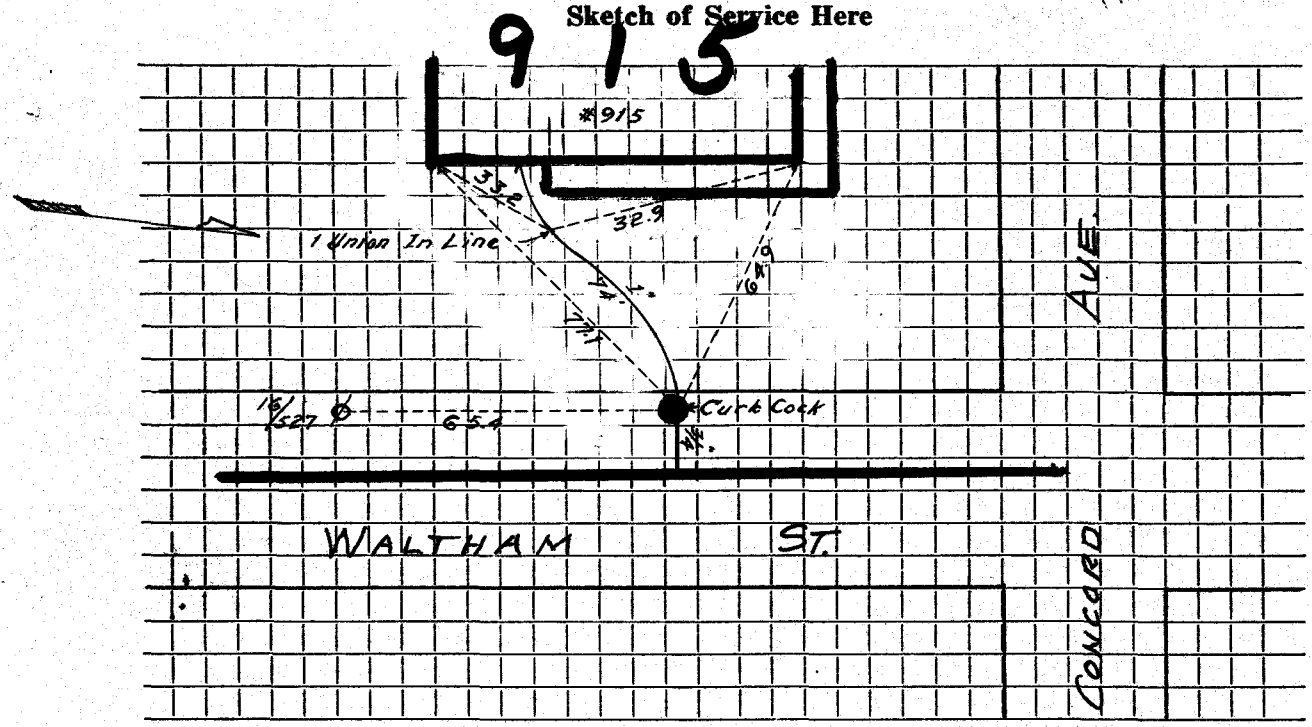

Connection made in ..... Street. Work completed .....

Remarks: .....  
.....  
.....