

WATER SERVICE RECORD

Name

Service No.

Address #942 Waltham St.

Location

Repair—Renewal—New Service


Date	Material	Amount	Total	Date	Amount
5/5/47	Labor	5.00			
5/7/82	"	29.24			
5/8/82	"	1.05	35. 29		
	10 % O.H.	3. 53	38. 82		
					OUTSIDE
63'	3/4" Copper tubing @ .27		17 01	5/7/82	Labor 34.48
1	3/4" C x 1/2" I.W.H. Stop & Waste		3. 15	5/8/82	" 10.33
1	3/4" C x 3/4" C union 3 part		1 17		32' 3/4" Copper tubing @.27
	Patching 27' x 3'		27. 00	1	3/4" C Corp Cock
1	hr. Trucking @ .75		75	1	3/4" C x 3/4" Curb Cock
			<u>82. 90</u>	1	Box & Rod
				1	1/2" Offset Tail Piece
				1	1/2" Straight Tail Piece
				2	hrs. Compressor @ 1.75
				1	hr. Trucking @.75
					<u>68.73</u>

DATE _____

TOWN OF LEXINGTON — BOARD OF PUBLIC WORKS

WATER DIVISION

Sketch of Service Here

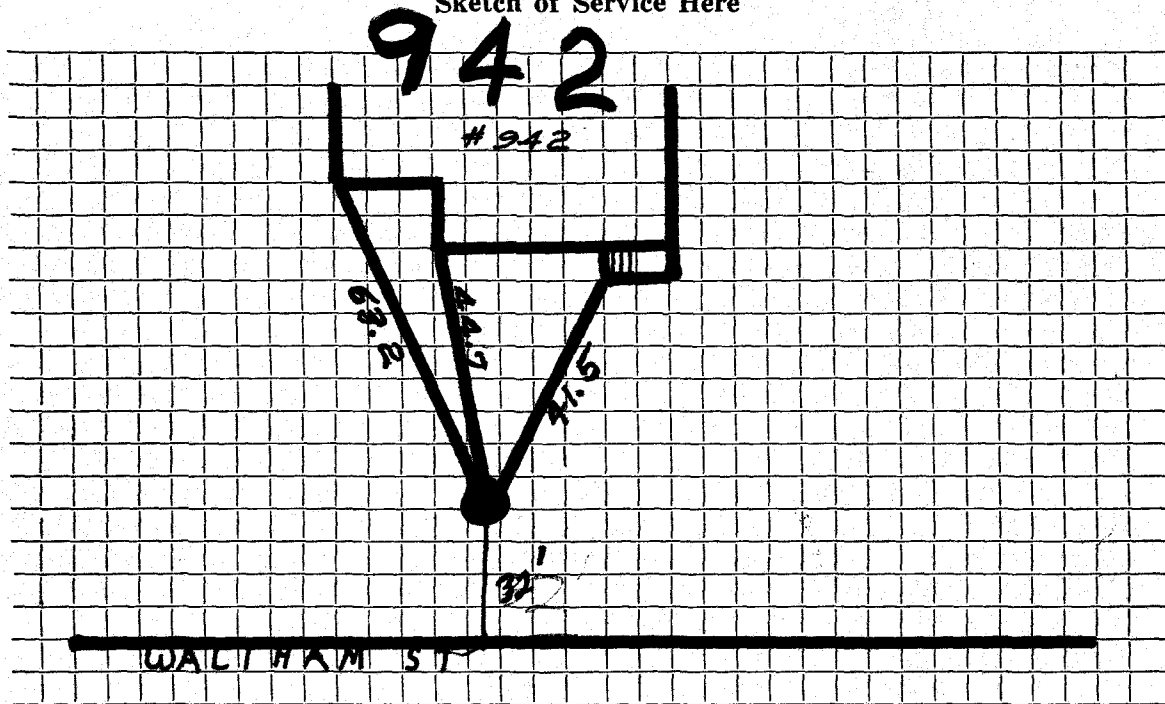

Connection made in Street. Work completed

Remarks:

.....

.....